PARENT PARCEL: 03-00-039-105-004, -005, -006

CHILD PARCEL: 03-00-039-105-056 & -057 14WD LOR-US-6-13.69

STARTING POINT: MAG. NAIL, CL OF LAKE RD. & CL OF KENILWORTH AVE.

25-00820

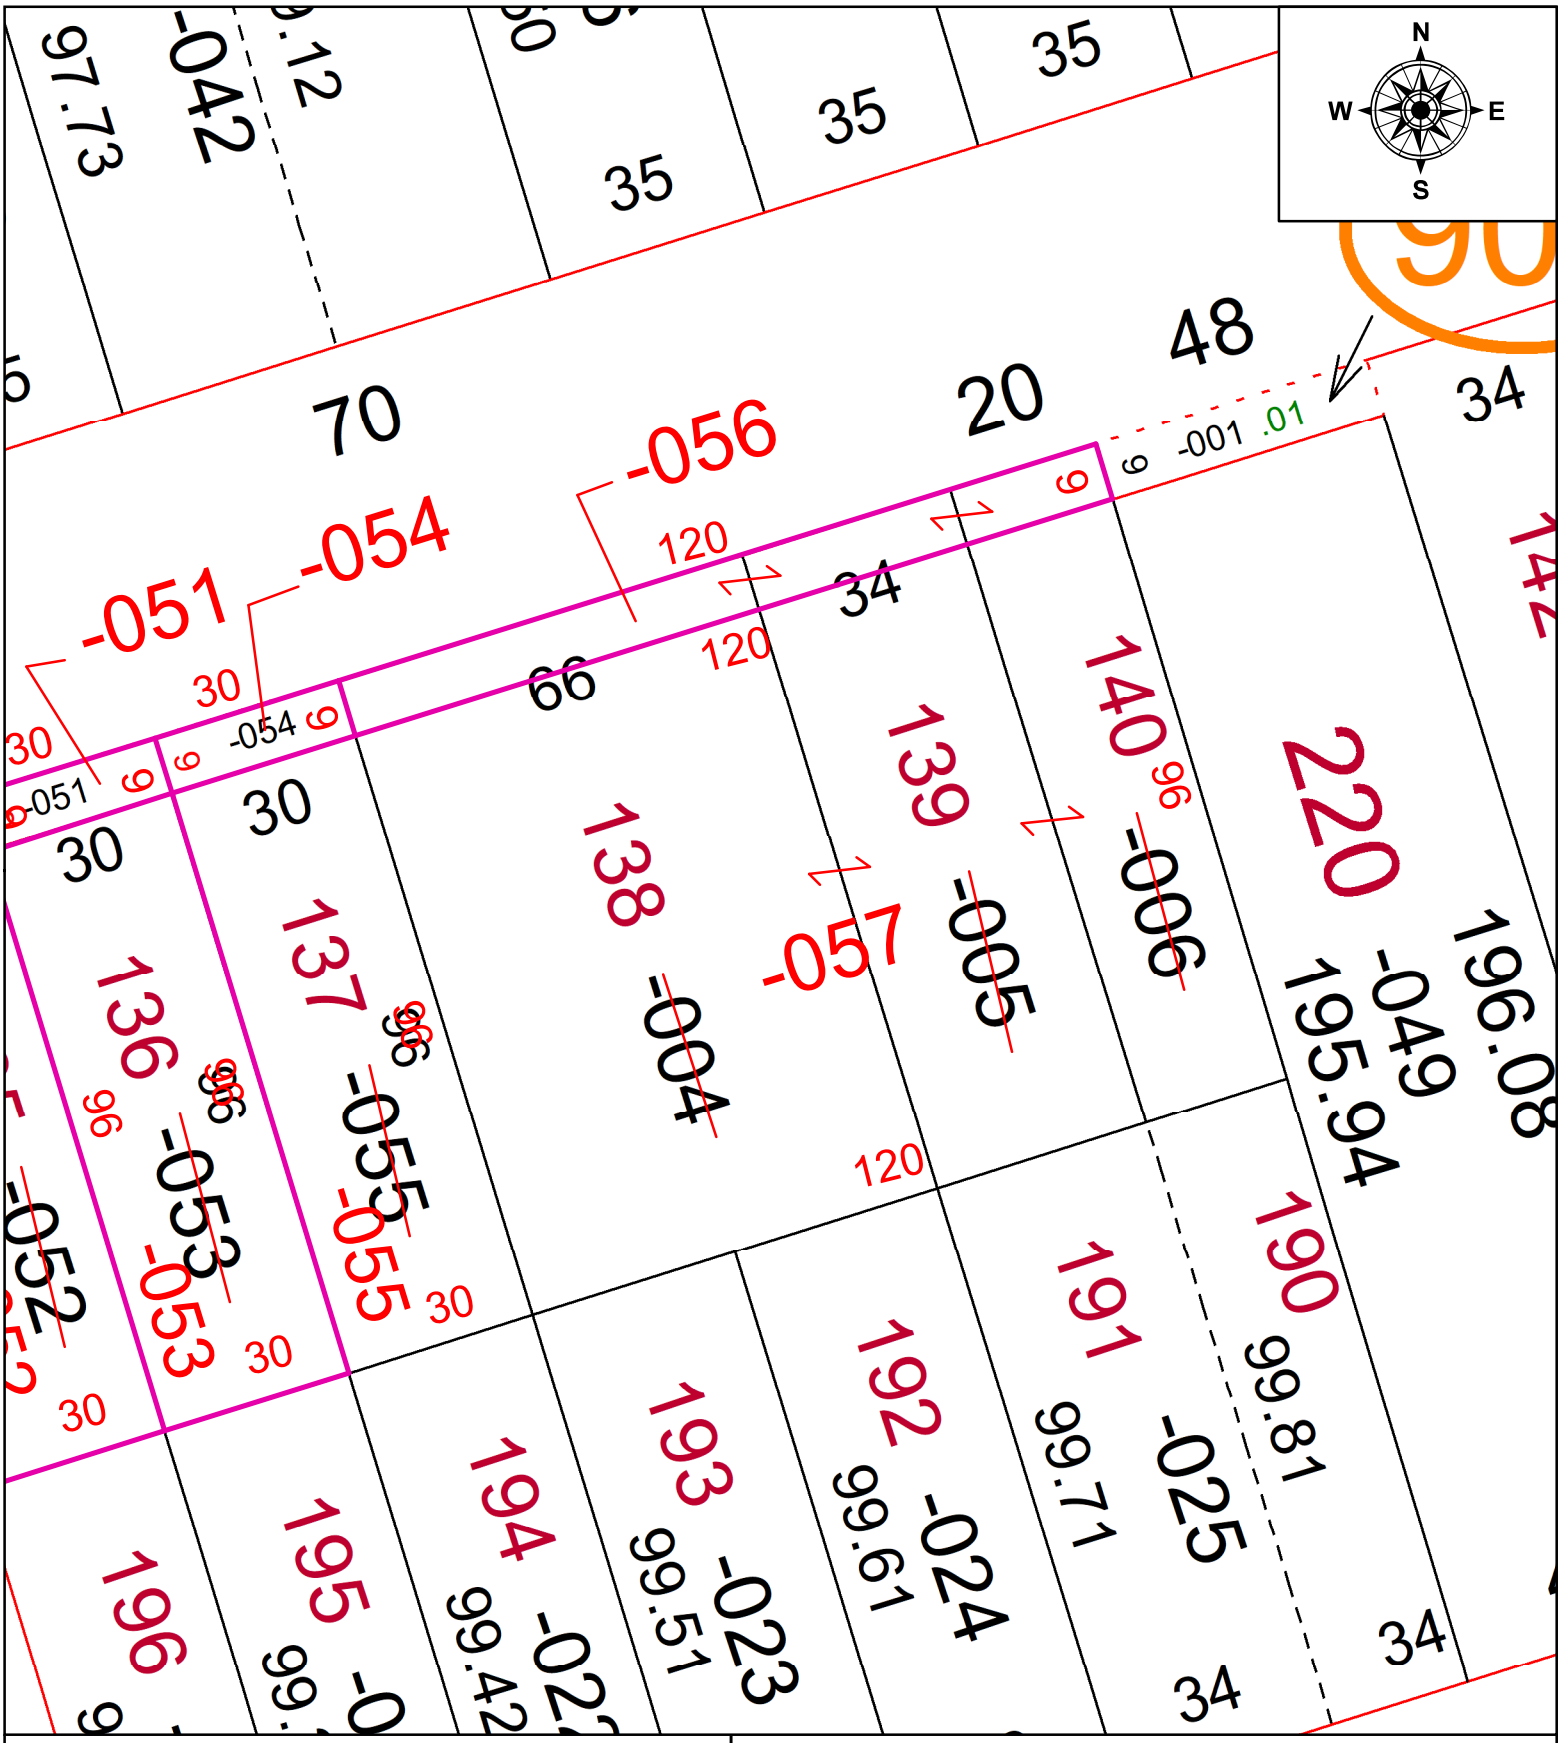

SPLITS/DEEDS PROCESSED

LORAIN COUNTY TAX MAP DEPARTMENT
226 MIDDLE AVE. ELYRIA, OH

SURVEYED BY: AMY KELLY
CLOSURE: 1: INF
MAP PAGE(S): 03-00-039
APPOVED BY: TJS **DATE:** 2/26/2025
SCALE: 1" = 30' **PRIOR INSTRUMENT:** 2022-0867416