RASTER

NT PARCEL: 09-00-067-000-025, 028, 029
LD PARCEL: 09-00-067-000-033, 034, 035
STARTING POINT: SOUTHEASTERLY CORNER OF O.L. 67

~~NO. 00294~~
#01-00509-X

THIS P.P.N. -028 WAS NEVER ADDED TO TRANSFER SHEET WHEN #00294 WAS PROCESSED AS A SPLIT/COMB.

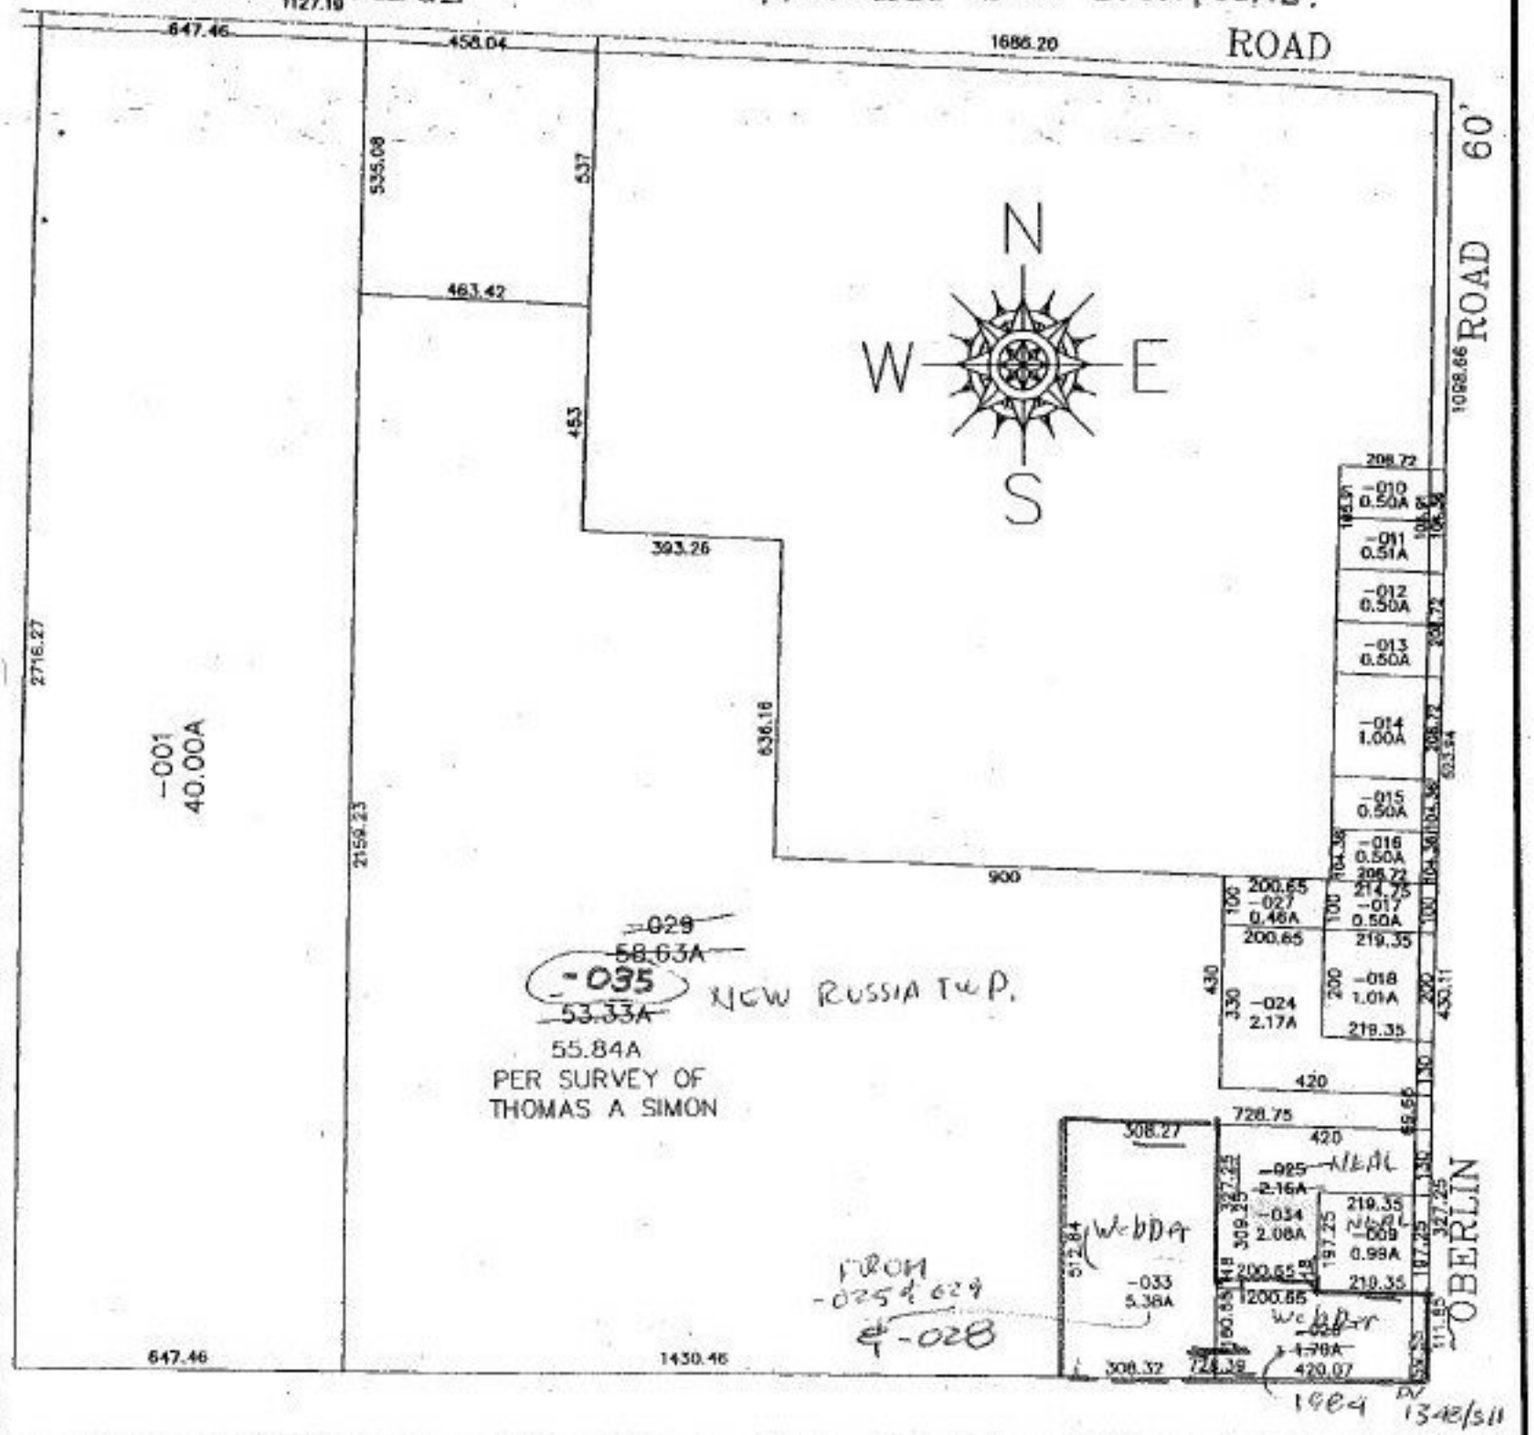

SPLITS/DEEDS PROCESSED
LORAIN COUNTY TAX MAP DEPARTMENT
226 MIDDLE AVE. ELYRIA, OHIO

SURVEYED BY: THOMAS A SIMON
CLOSURE: 0.02 / 10,000
MAP PAGE(S): 9-00-067-A & B
APPROVED BY: F. COLBERT DATE: 12/13/99
SCALE: 1" = 400 PRIOR INSTRUMENT: DV XXXX/XXX