RASTER

PARENT PARCEL: 07-00-009-114-044
CHILD PARCEL: 07-00-009-114-048 , 07-00-009-115-040 THRU -042
STARTING POINT: BEING S\L 20 & HALF OF VAC. ALLEY & HALF OF VAC. MADISON AVE.

NO. 00511-V

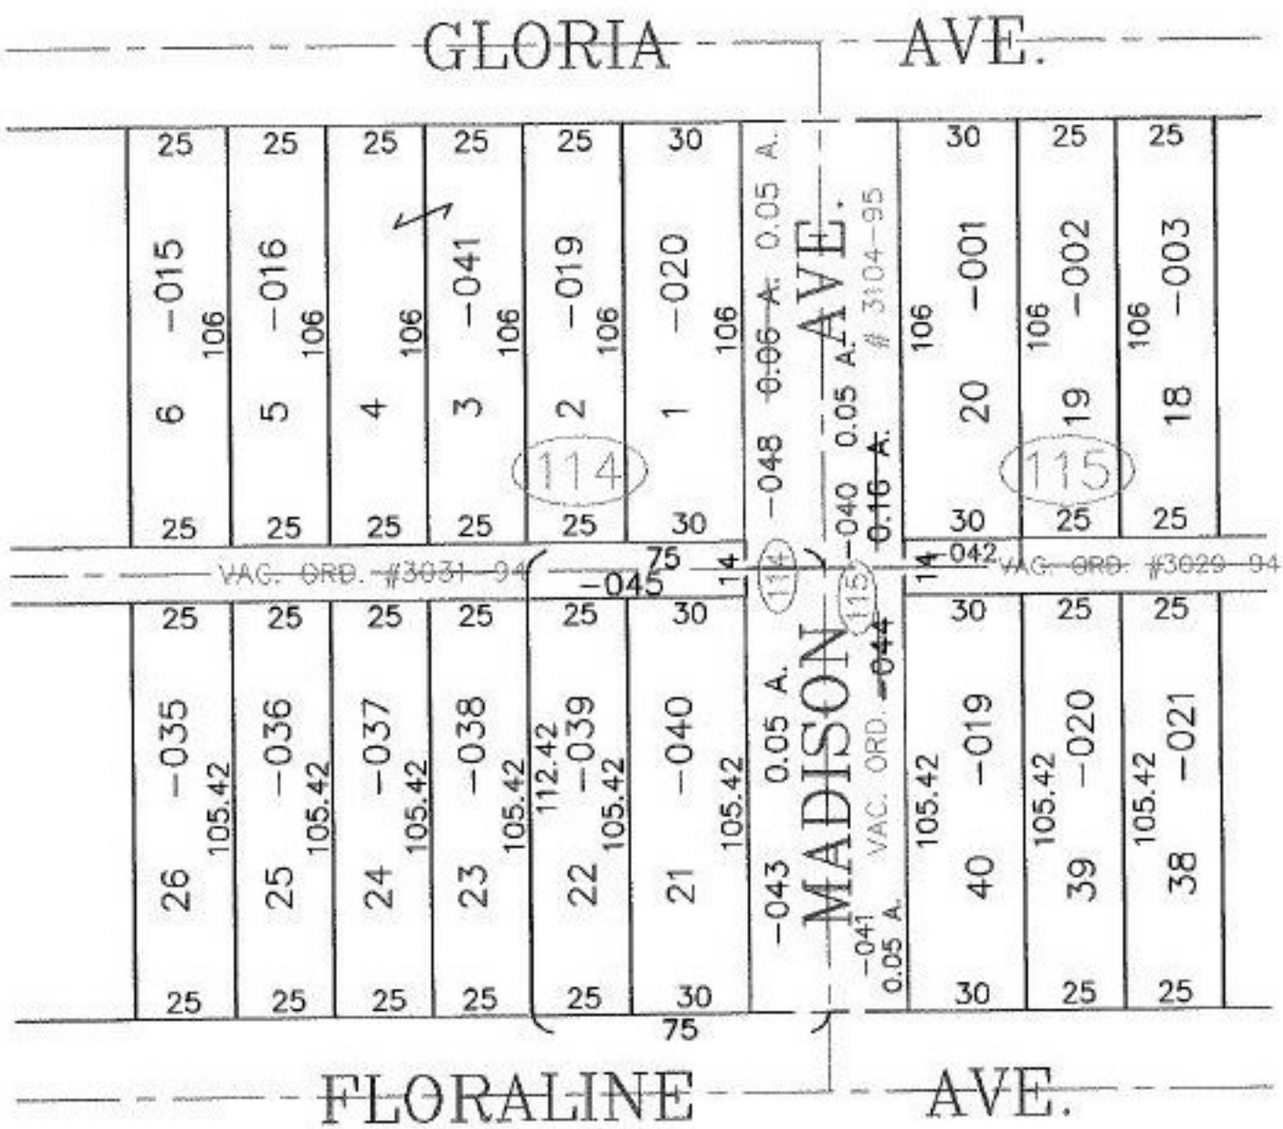

SPLITS/DEEDS PROCESSED

LORAIN COUNTY TAX MAP DEPARTMENT
226 MIDDLE AVE. ELYRIA, OHIO

SURVEYED BY: NONE
CLOSURE: CAN'T RUN
MAP PAGE(S): 07-00-009-A
APPROVED BY: TJS DATE: 02/09/01
SCALE: 1"= 50' PRIOR INSTRUMENT: 980586149