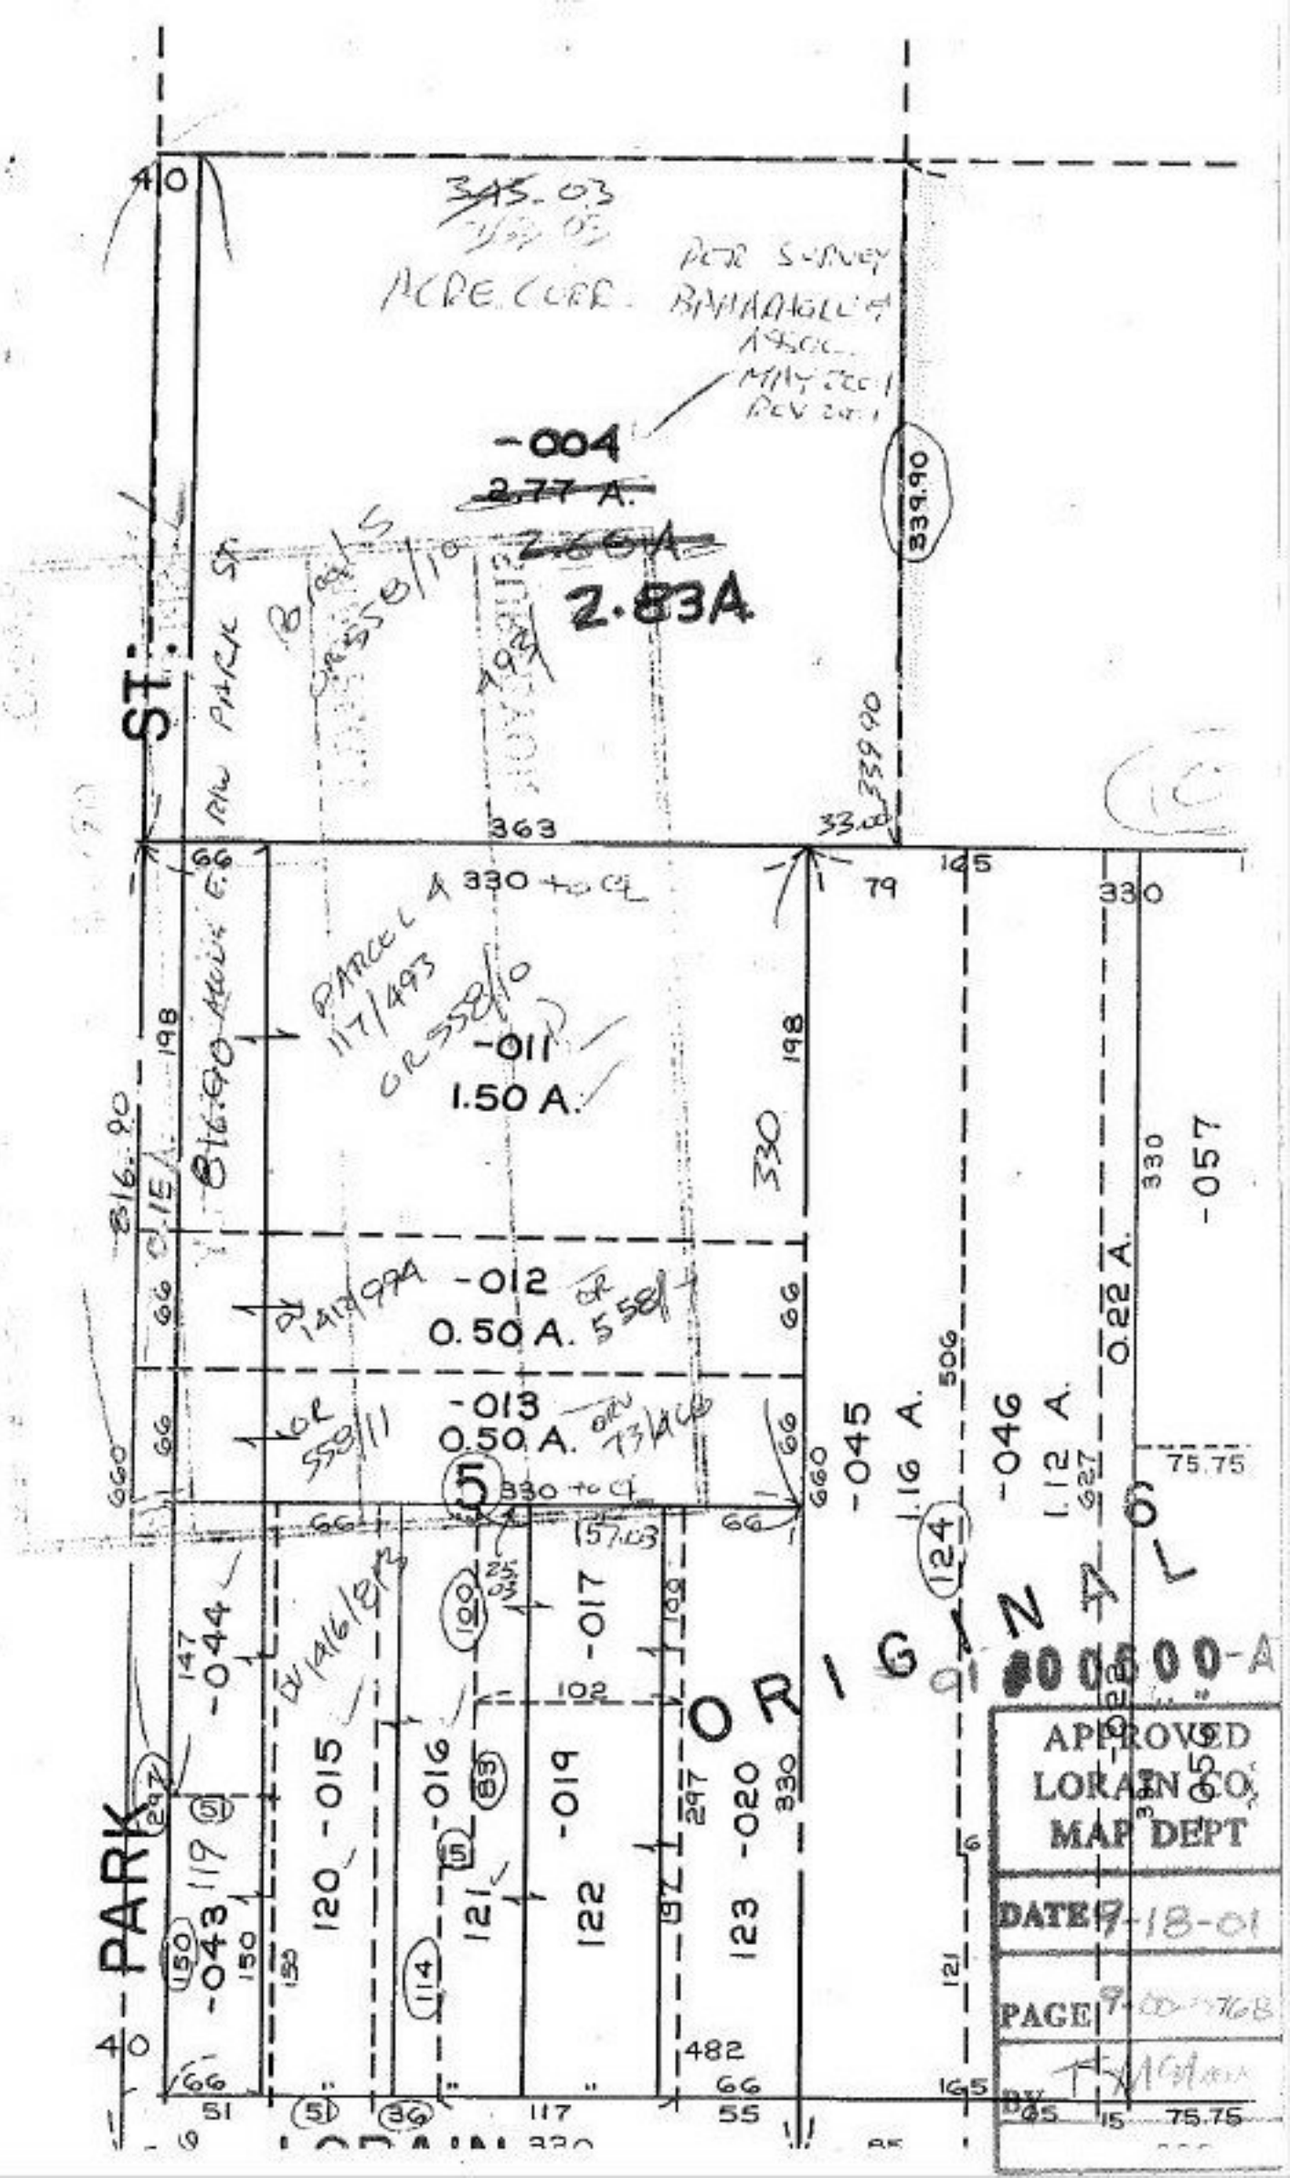

ACRE CORR.
-004
2.77 A.
2.83A
ST.
PARK
-011
1.50 A.
-012
0.50 A.
-013
0.50 A.
-045
1.16 A.
-046
1.12 A.
0.22 A.
-057
-044
-043
120 -015
-016
121
-017
122
-019
123 -020
ORIGINAL
APPROVED
LORAIN CO.
MAP DEPT
DATE 9-18-01
PAGE
BY