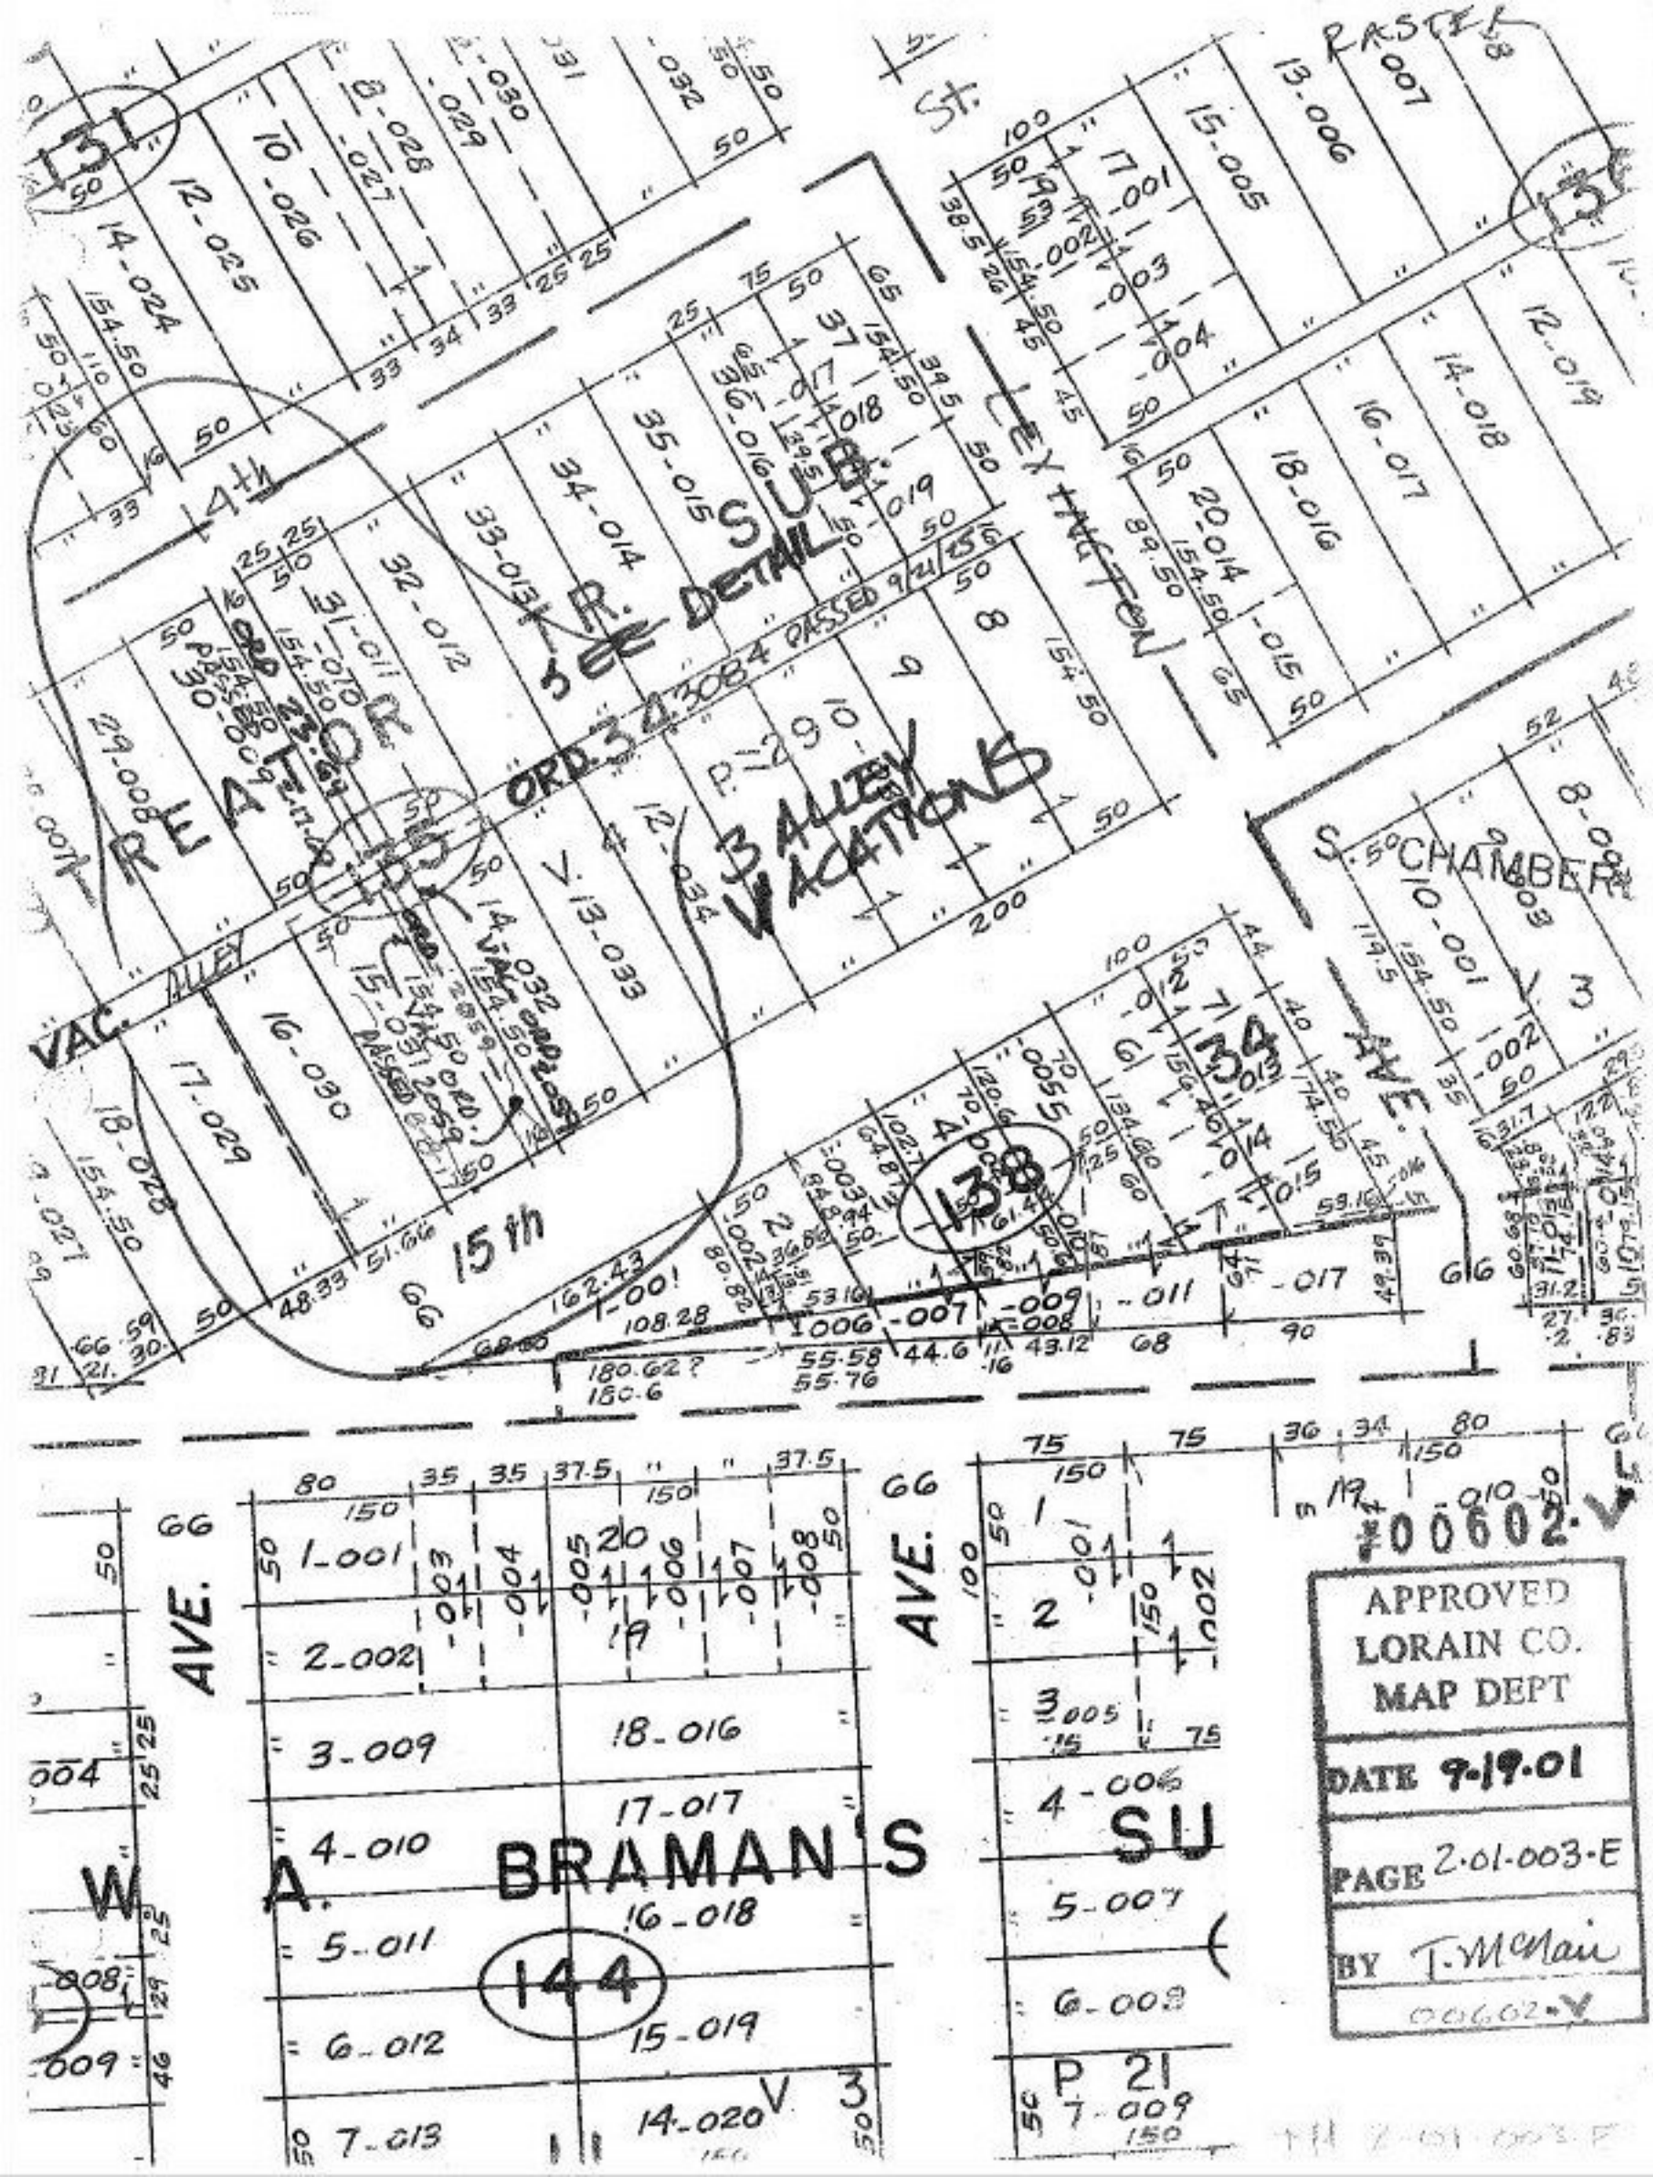

TREATOR SUB.
SEE DETAIL
ORD. 34 3084 PASSED 9/21/25
3 ALLEY VACATIONS
LEXINGTON
S. CHAMBERS
VAC. ALLEY
15th
14th
RASTER
AVE.
W. A. BRAMAN'S SU
144
#00602-V
APPROVED
LORAIN CO.
MAP DEPT
DATE 9-19-01
PAGE 2-01-003-E
BY T. McNair
00602-V