RASTER

PARENT PARCEL: 04-00-026-109-007
CHILD PARCEL: 04-00-026-109-096, -097
STARTING POINT: CENTERLINE OF LEAR NAGEL RD. & SCHWARTZ RD.

NO. 00710

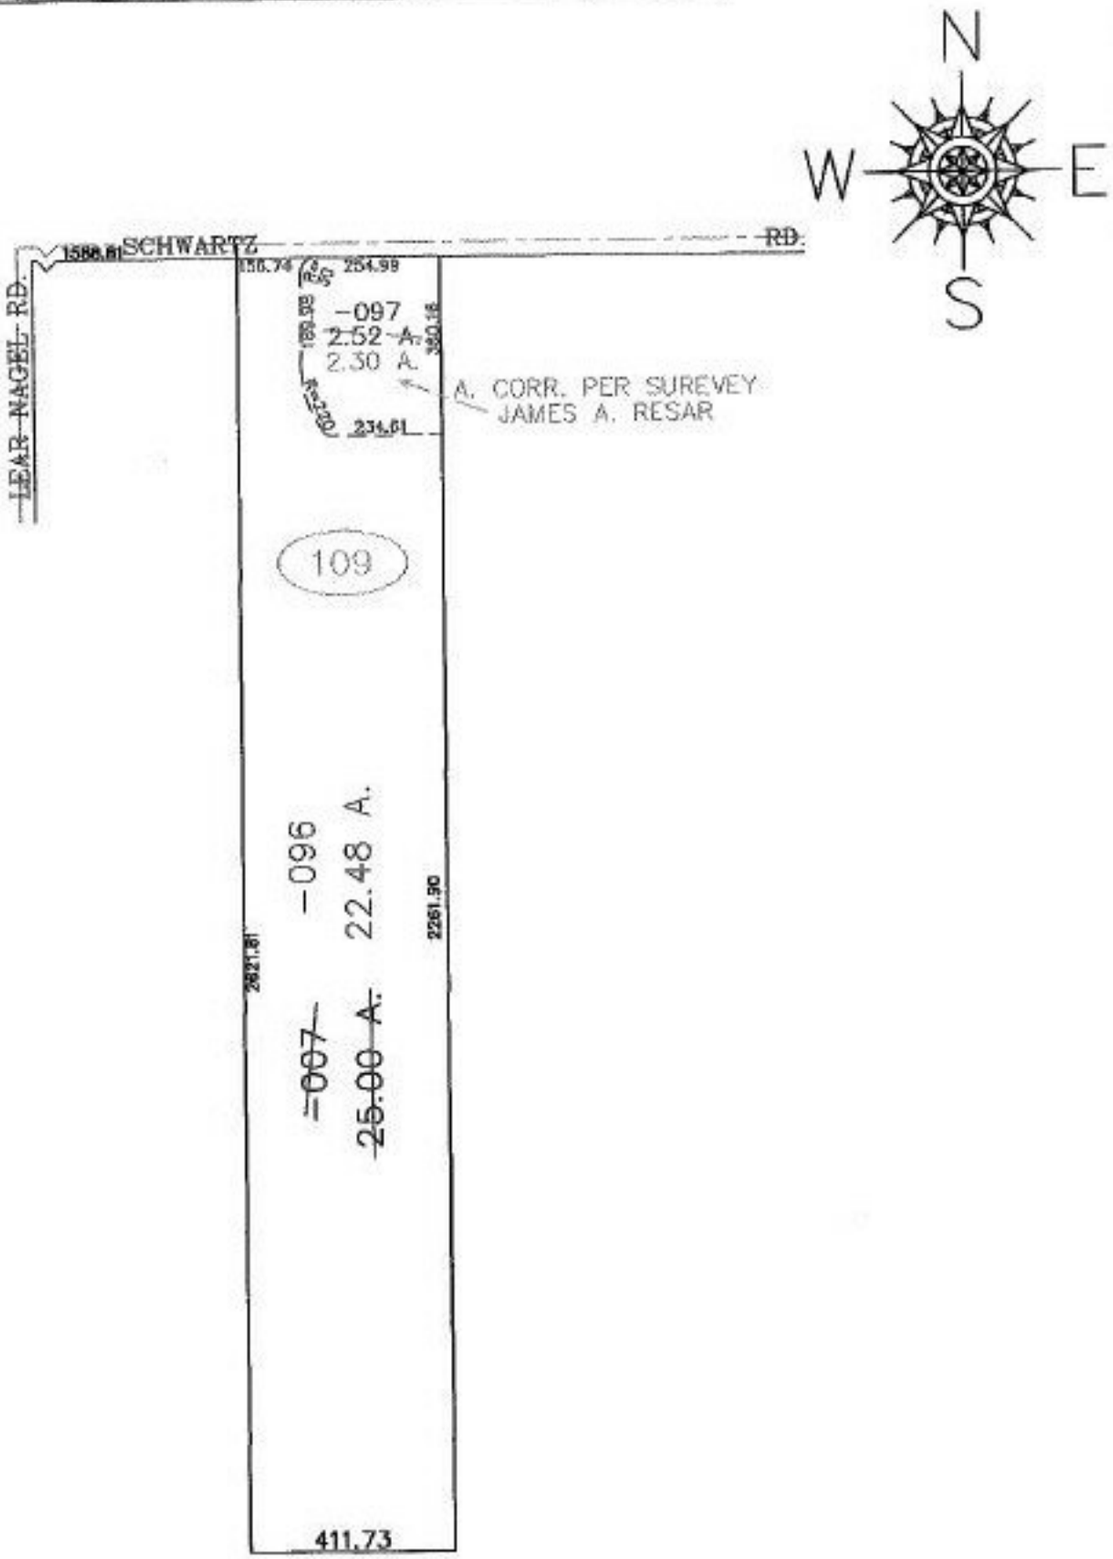

SPLITS/DEEDS PROCESSED
LORAIN COUNTY TAX MAP DEPARTMENT
226 MIDDLE AVE. ELYRIA, OHIO

SURVEYED BY: JAMES A. RESAR
CLOSURE: 0.01 : 10.000
MAP PAGE(S): 4-00-026-F
APPROVED BY: JAH DATE: 4-05-01
SCALE: 1"= 400 PRIOR INSTRUMENT: OR 30/587