RASTER

PARENT PARCEL: 05-00-056-000-037, -048 05-00-057-000-012
CHILD PARCEL: 05-00-057-000-300, -301 05-00-056-000-061
STARTING POINT: CENTERLINE OF MIDDLE RIDGE RD. & OBERLIN RD.

NO. 00717

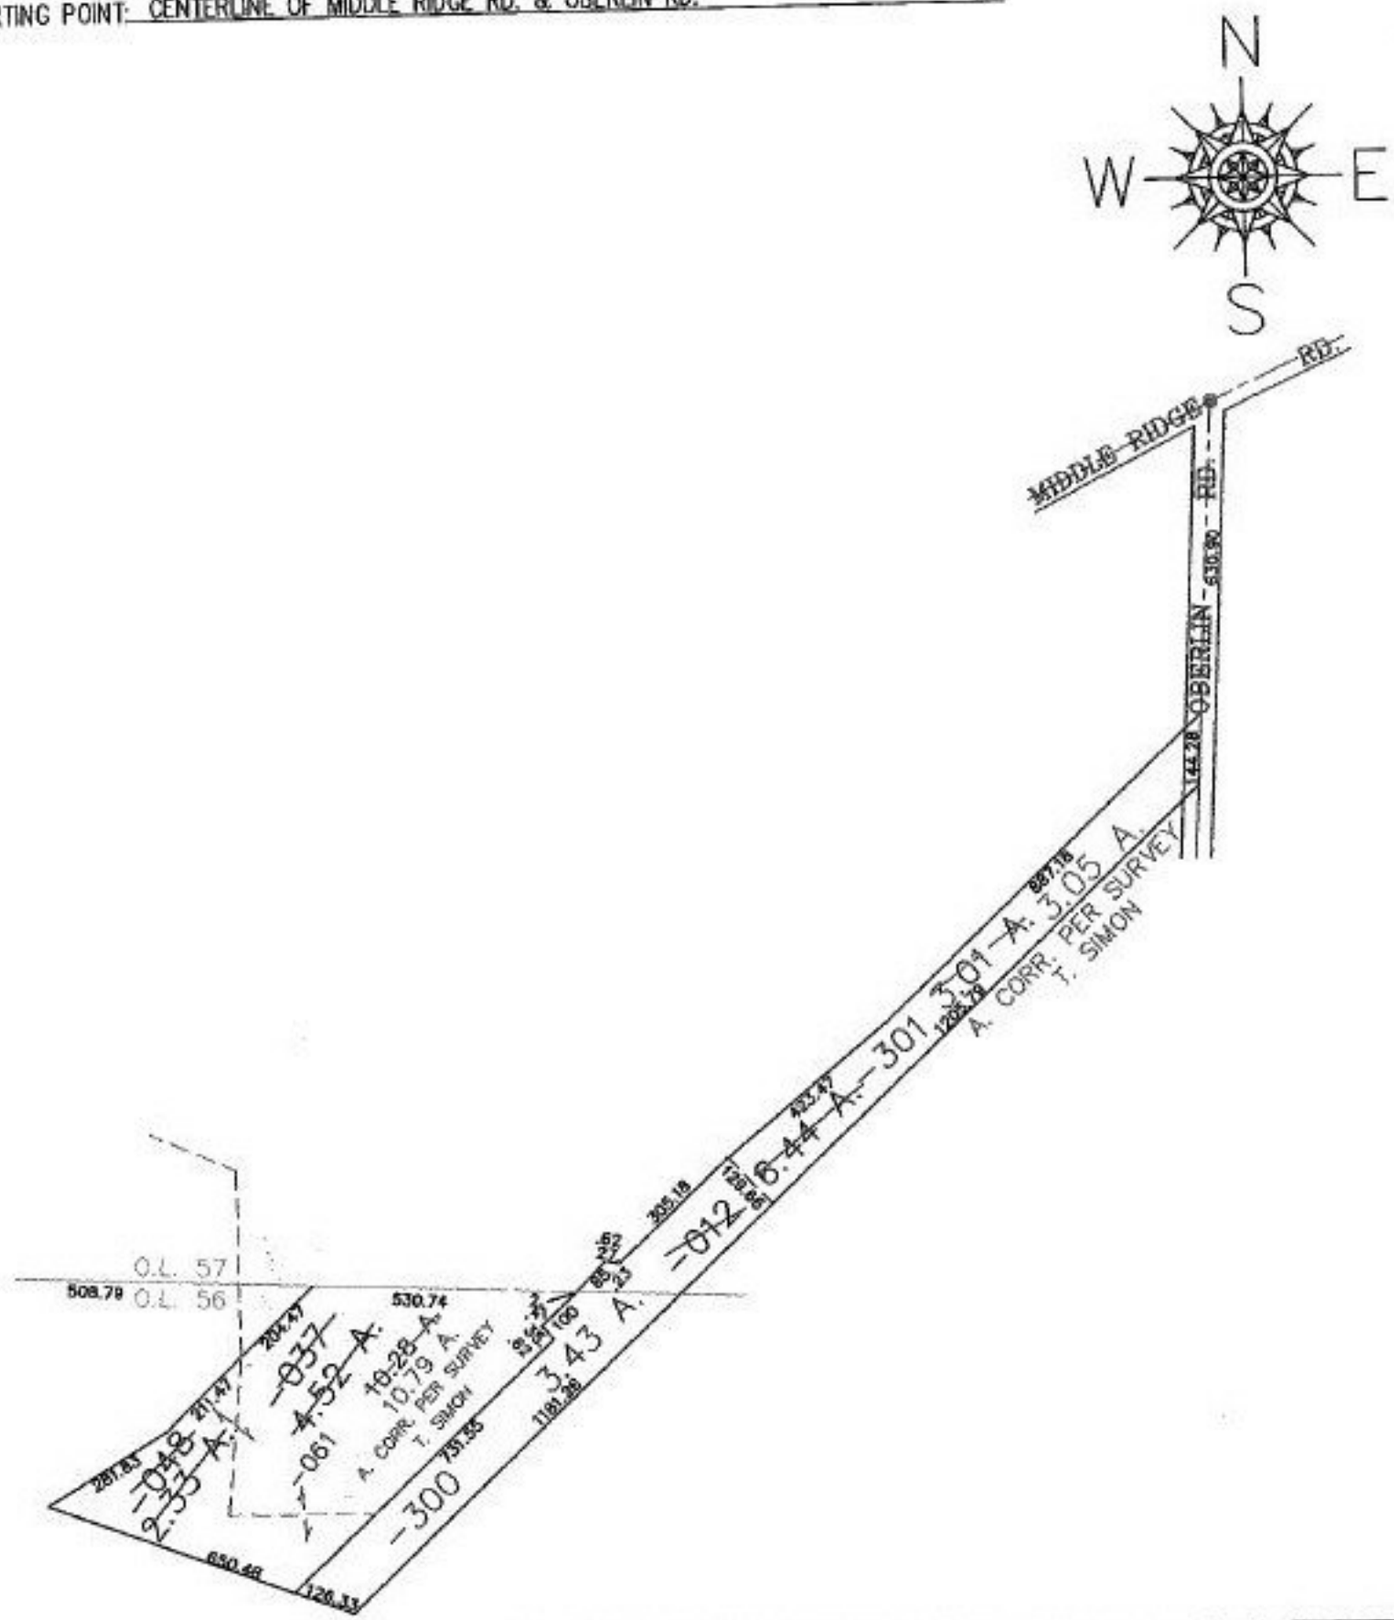

SPLITS/DEEDS PROCESSED
LORAIN COUNTY TAX MAP DEPARTMENT
226 MIDDLE AVE. ELYRIA, OHIO

SURVEYED BY: THOMAS A. SIMON
CLOSURE: 0.00 : 10,000
MAP PAGE(S): 5-00-056-A, 05-00-057-B
APPROVED BY: XXX DATE: 4-16-01
SCALE: 1"= 400 PRIOR INSTRUMENT: 623119