RASTER

NO. 00735

PARENT PARCEL: * SEE BELOW

CHILD PARCEL: ** SEE BELOW

STARTING POINT: CENTERLINE OF WEST RIDGE RD. & O.L. 83

* 05-00-079-000-025 THRU -028, -054
* 05-00-083-000-007, -008
* 05-00-082-000-005, -008, -009, -011, -019, -020, -023
* 05-00-078-000-023

** 05-00-079-000-088
** 05-00-078-000-023
** 05-00-083-000-017, -018
** 05-00-082-000-028, -029

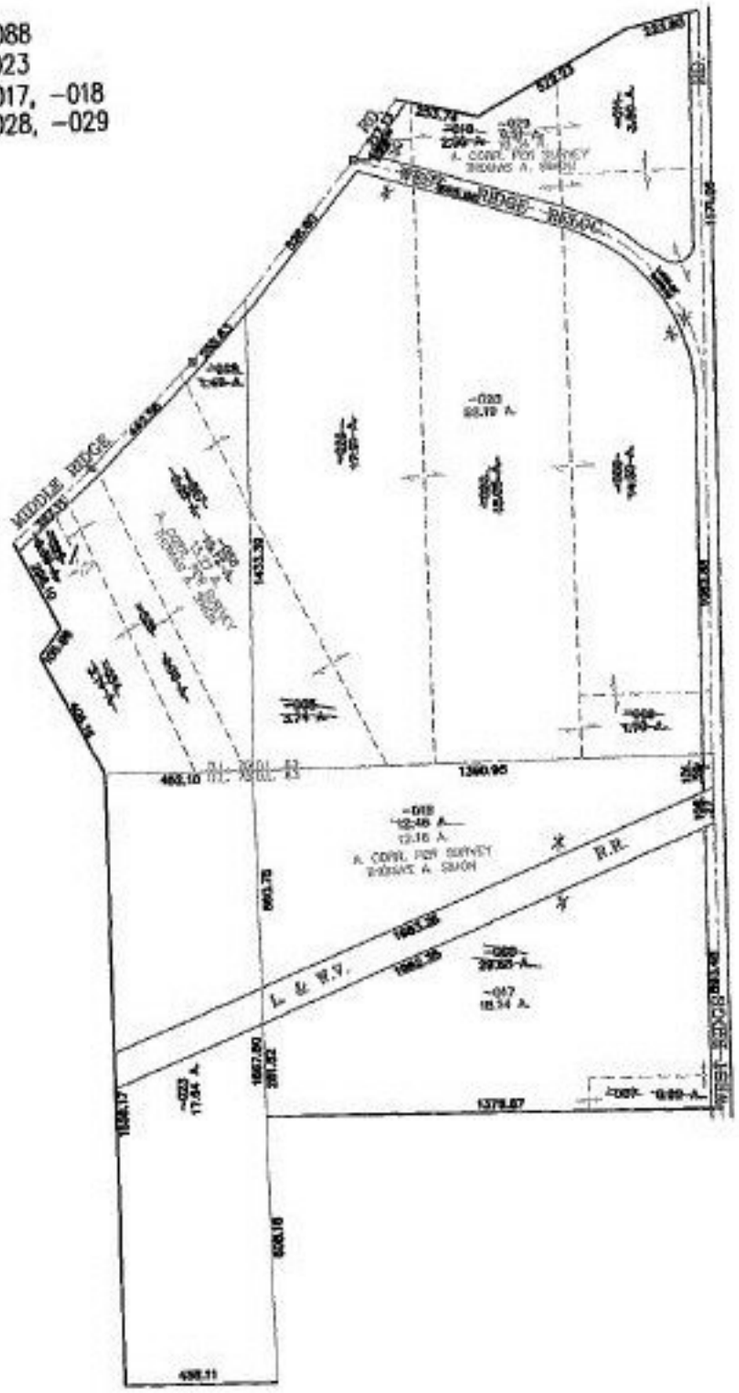

SPLITS/DEEDS PROCESSED

LORAIN COUNTY TAX MAP DEPARTMENT
226 MIDDLE AVE. ELYRIA, OHIO

SURVEYED BY: THOMAS A. SIMON
CLOSURE: 0.01 : 10,000
MAP PAGE(S): 05-00-078-B, -079-B, -082, -083
APPROVED BY: JAH DATE: 4-30-01
SCALE: 1" = 600 PRIOR INSTRUMENT: 20010744276