RASTER

PARENT PARCEL: 19-04-048-000-026, -013

CHILD PARCEL: 19-04-048-000--028 THRU -036

STARTING POINT: CENTERLINE OF NORWALK-MEDINA RD. & VERMONT ST.

NO. 00764

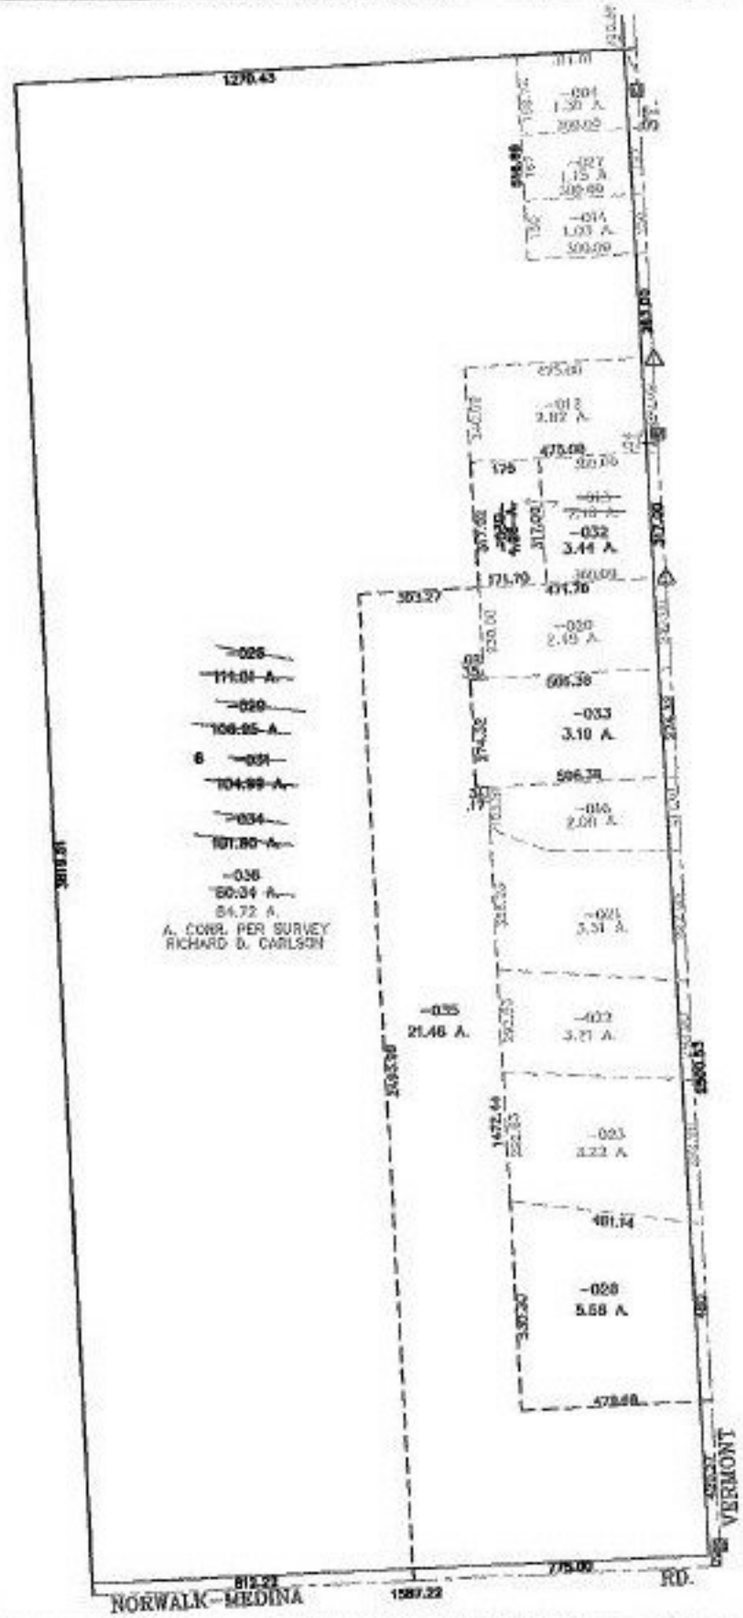

SPLITS/DEEDS PROCESSED

LORAIN COUNTY TAX MAP DEPARTMENT
226 MIDDLE AVE. ELYRIA, OHIO

SURVEYED BY: RICHARD D. CARLSON

CLOSURE: 0.01 : 10,000

MAP PAGE(S): 19-D

APPROVED BY: JAH DATE: 5-30-01

SCALE: 1"= 100 PRIOR INSTRUMENT: 2000699319