RASTER

PARENT PARCEL: 03-00-002-101-126
CHILD PARCEL: 03-00-002-101-127 THRU -132 & 03-00-002-900-005
STARTING POINT: CL OF DETROIT RD. & CL OF RESERVE WAY

NO. 00767

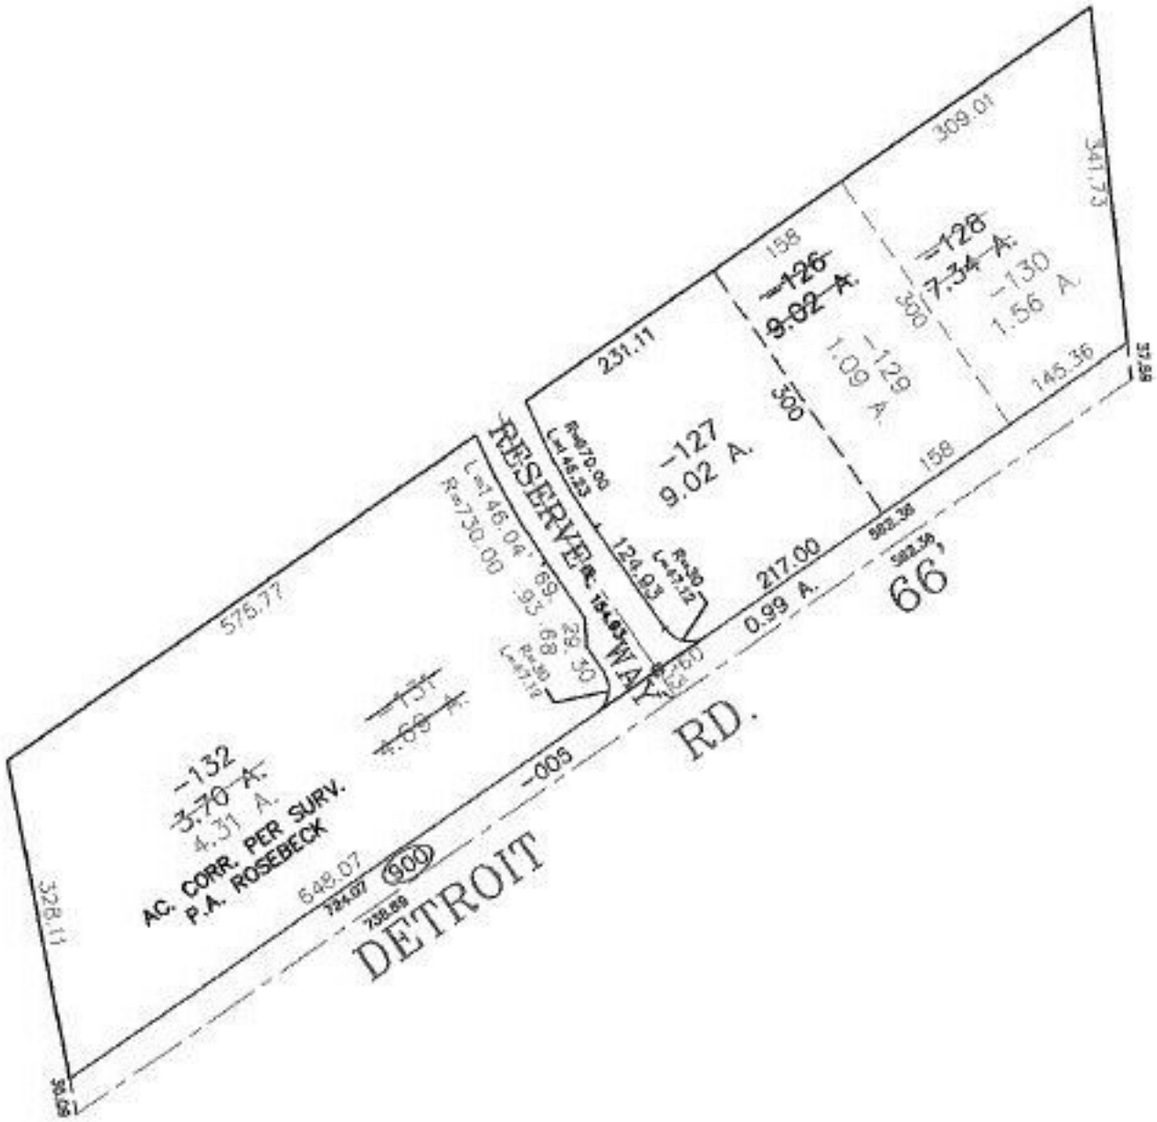

SPLITS/DEEDS PROCESSED
LORAIN COUNTY TAX MAP DEPARTMENT
226 MIDDLE AVE. ELYRIA, OHIO

SURVEYED BY: P.A. ROSEBECK
CLOSURE: 0.01 : 10,000
MAP PAGE(S): 3-L & 3-00-002-A
APPROVED BY: TJS DATE: 7/19/01
SCALE: 1"= 200 PRIOR INSTRUMENT: OR 402/588