RASTER

PARENT PARCEL: 04-00-013-000-176, -085, -175, -100

CHILD PARCEL: 04-00-013-000-437 THRU -446

STARTING POINT: CENTERLINE OF AVON-BELDEN RD. & MILLS RD.

NO. 00779

N

W E

S

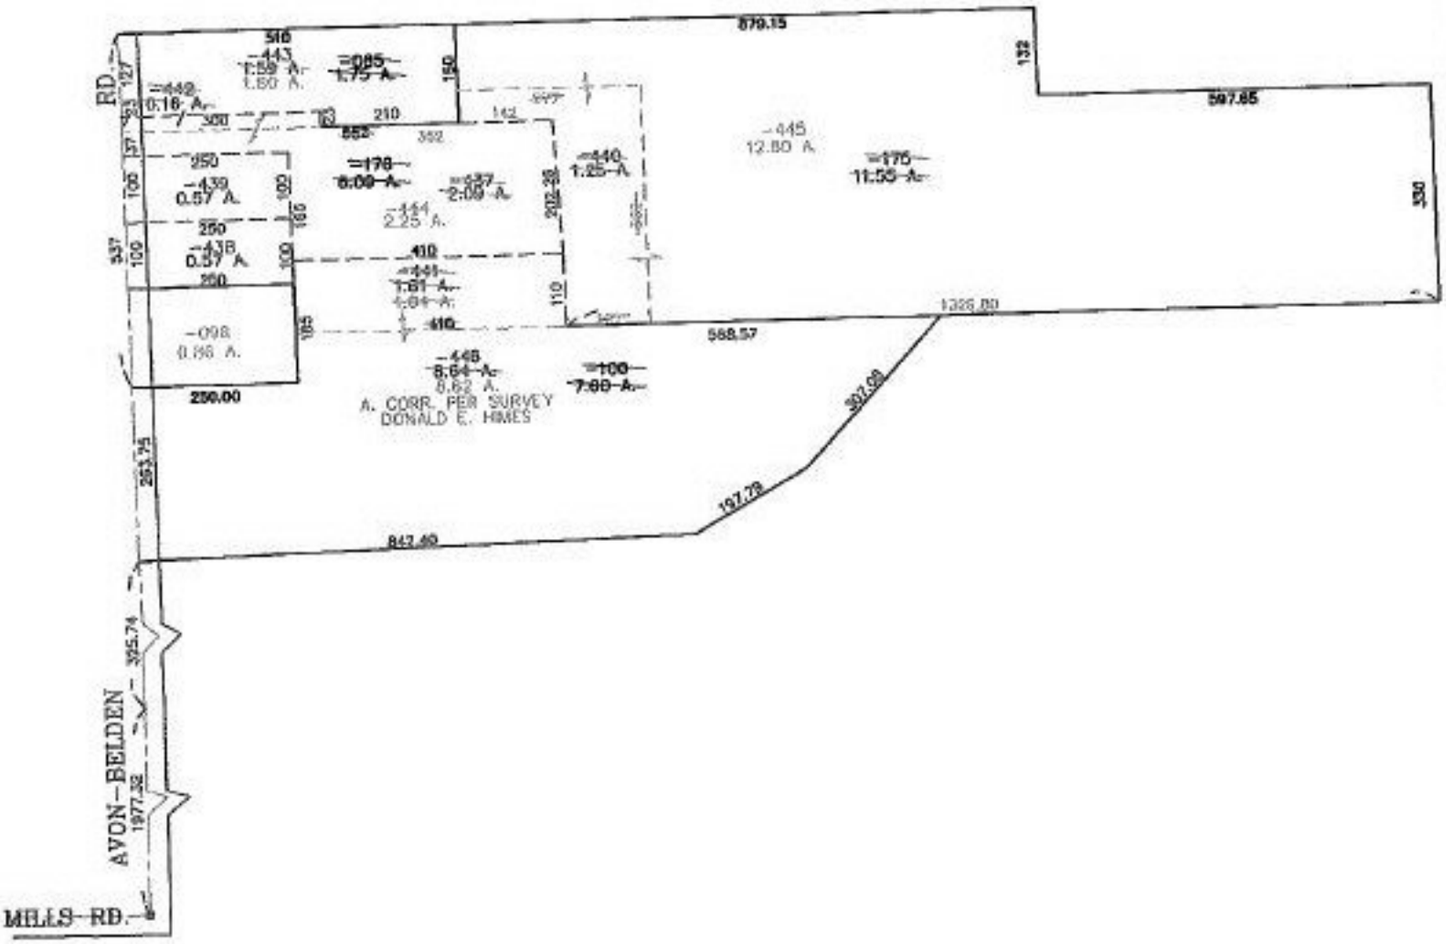

SPLITS/DEEDS PROCESSED

LORAIN COUNTY TAX MAP DEPARTMENT
226 MIDDLE AVE. ELYRIA, OHIO

SURVEYED BY: DONALD E. HIMES

CLOSURE: 0.00 : 10,000

MAP PAGE(S): 4-00-013-G

APPROVED BY: JAH DATE: 7-18-01

SCALE: 1"= 300 PRIOR INSTRUMENT: 990645250