RASTER

PARENT PARCEL: 05-00-061-101-018, 05-00-060-103-037, -029
CHILD PARCEL: 05-00-060-103-038, -039 05-00-061-101-032 THRU -045
STARTING POINT: CENTERLINE OF COOPER FOSTER RD. & OBERLIN RD.

NO. 00809

N
W E
S

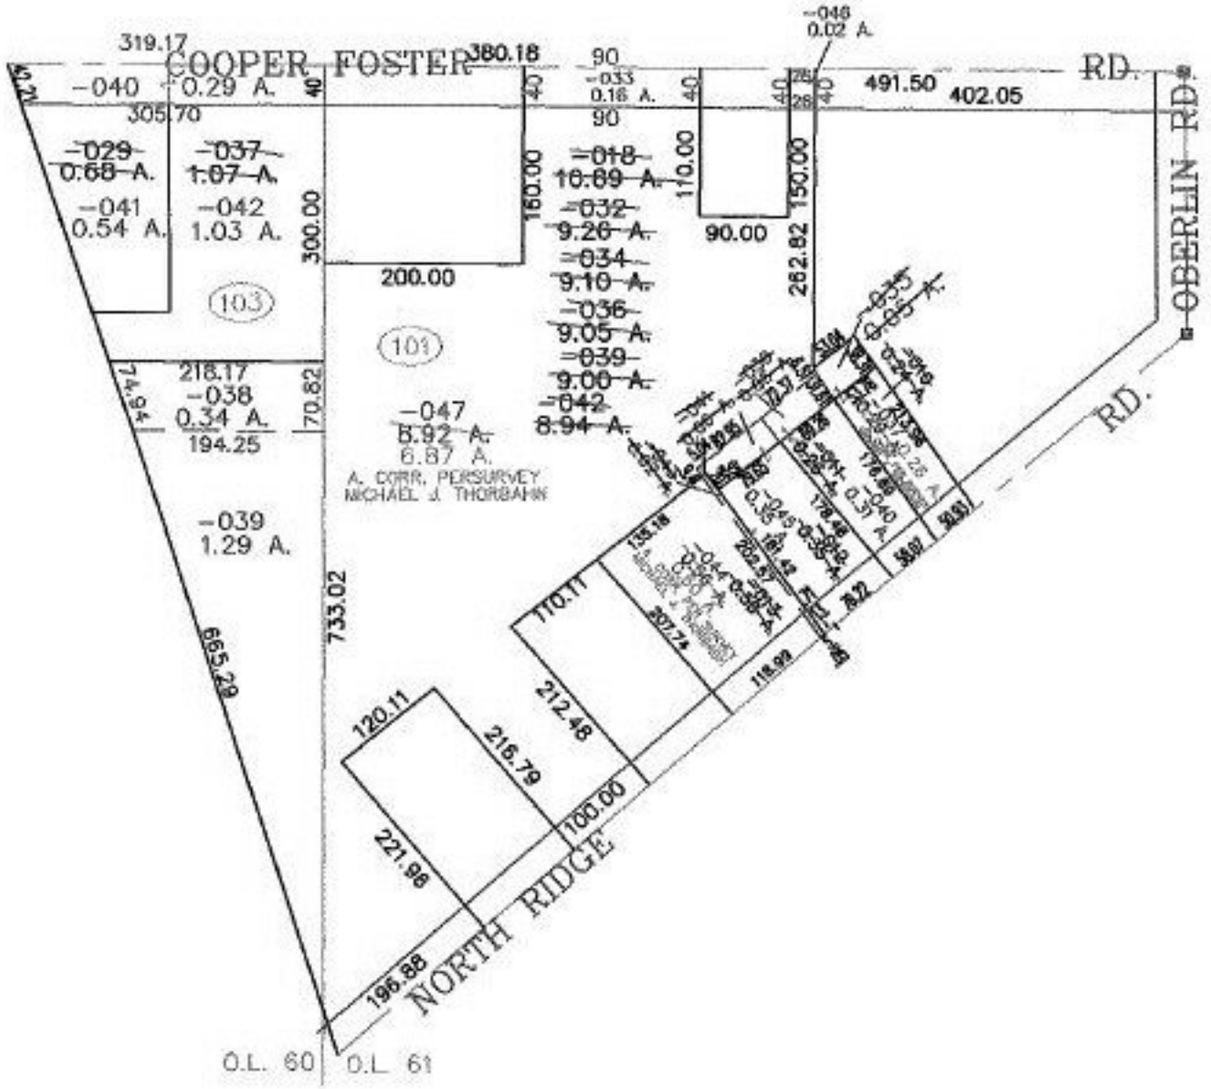

SPLITS/DEEDS PROCESSED
LORAIN COUNTY TAX MAP DEPARTMENT
226 MIDDLE AVE. ELYRIA, OHIO

SURVEYED BY: DAVE L. ELWELL/MICHAEL J. THORBAHN
CLOSURE: 0.00 : 10,000
MAP PAGE(S): 05-00-060-B, -061-A
APPROVED BY: JAH DATE: 8-15-01
SCALE: 1"= 200 PRIOR INSTRUMENT: DV 1380/143