RASTER

PARENT PARCEL: 05-00-044-000-043, -031, -018, -019
CHILD PARCEL: 05-00-044-000-064 THRU -067, & 05-00-045-000-087
STARTING POINT: CL OF DEWEY RD. & NORTH LINE OF CONSOLIDATED RAIL CORP.

NO. 00815

N
W E
S

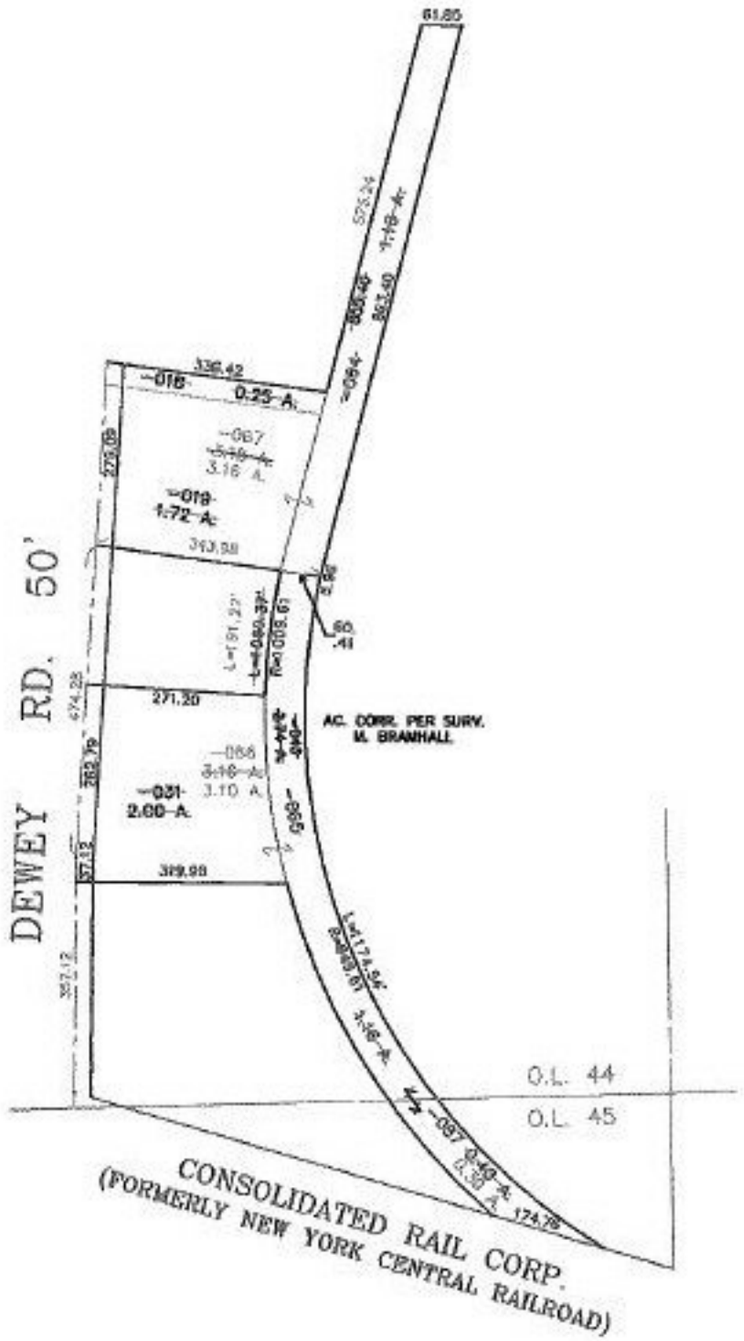

PRIOR INSTRUMENT: DV 1206/76
PRIOR INSTRUMENT: 970501543
PRIOR INSTRUMENT: 990595817

SPLITS/DEEDS PROCESSED
LORAIN COUNTY TAX MAP DEPARTMENT
226 MIDDLE AVE. ELYRIA, OHIO

SURVEYED BY: MICHAEL BRAMHALL
CLOSURE: 0.01 : 10,000
MAP PAGE(S): 05-00-044-B & 05-00-045- B
APPROVED BY: TJS DATE: 07/27/01
SCALE: 1"= 300