RASTER

PARENT PARCEL: 04-00-024-116-042
CHILD PARCEL: 04-00-024-116-193, -194
STARTING POINT: CENTERLINE OF CROWN COLONY DR. & VILAMOURA DR.

NO. 00817

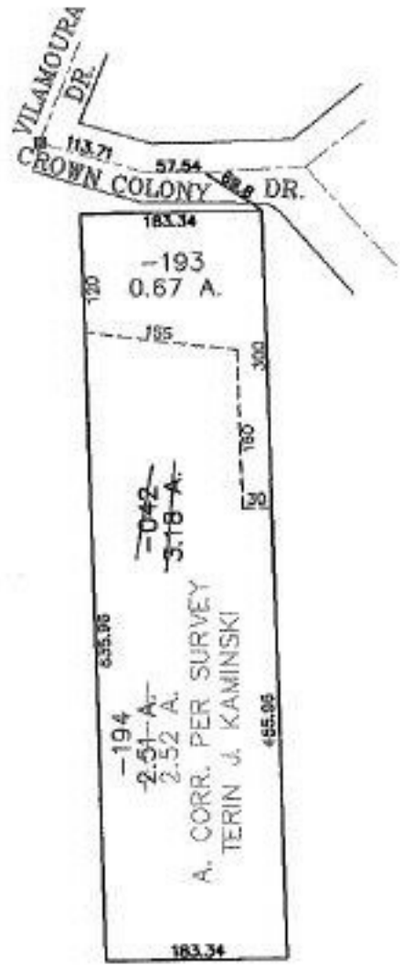

SPLITS/DEEDS PROCESSED
LORAIN COUNTY TAX MAP DEPARTMENT
226 MIDDLE AVE. ELYRIA, OHIO

SURVEYED BY: TERIN J. KAMINSKI
CLOSURE: 0.00 : 10,000
MAP PAGE(S): 4-00-024-H
APPROVED BY: JAH DATE: 7-26-01
SCALE: 1"= 200 PRIOR INSTRUMENT: 6233231472