RASTER

PARENT PARCEL: 04-00-024-115-138, -137
CHILD PARCEL: 04-00-024-115-145, -146
STARTING POINT: SIDELINE OF VILAMOURA DR. & S/L 310

NO. 00818

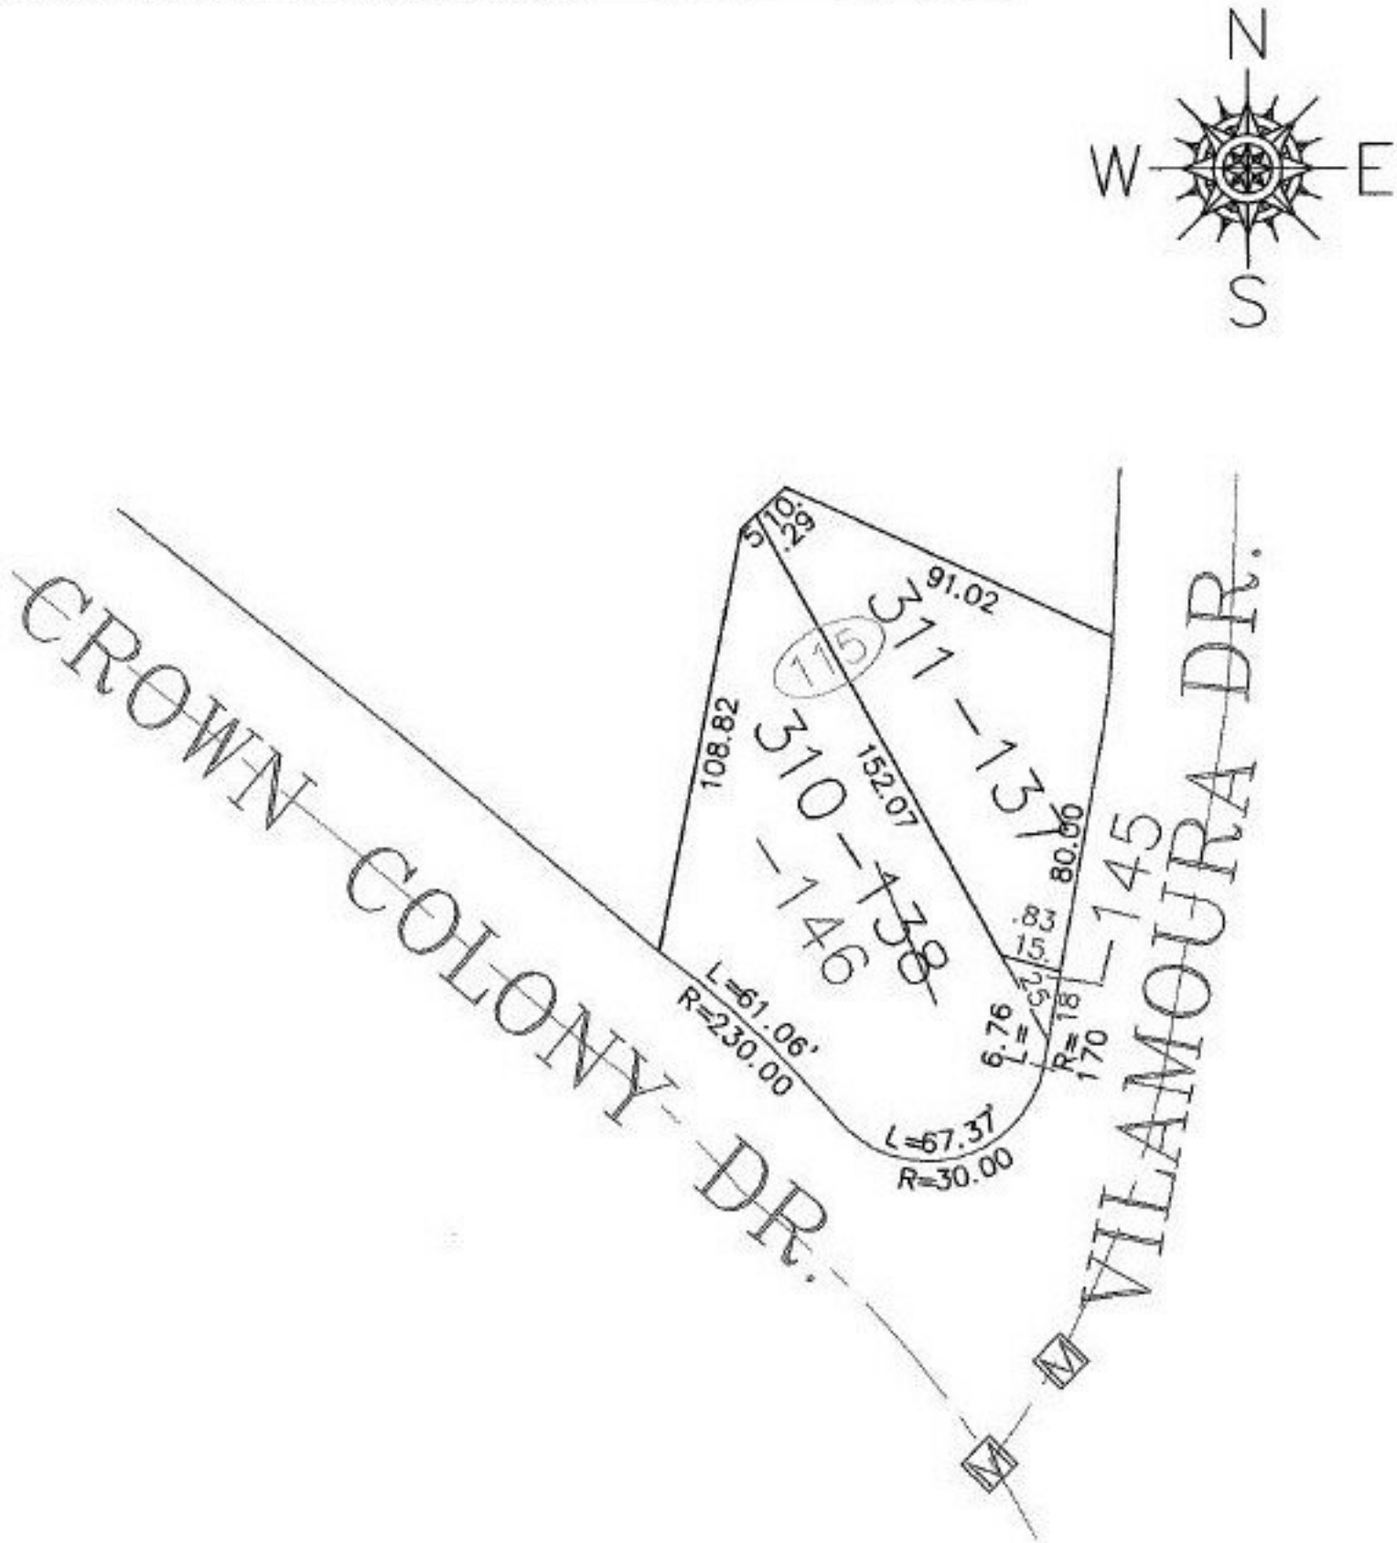

SPLITS/DEEDS PROCESSED
LORAIN COUNTY TAX MAP DEPARTMENT
226 MIDDLE AVE. ELYRIA, OHIO

SURVEYED BY: DAVID L. ELWELL
CLOSURE: 0.00 : 10.000
MAP PAGE(S): 4-00-024-H
APPROVED BY: JAH DATE: 7-30-01
SCALE: 1" = 50' PRIOR INSTRUMENT: 990630357