RASTER

PARENT PARCEL: 06-24-039-000-041
CHILD PARCEL: 06-24-039-000-074, -075
STARTING POINT: CENTERLINE OF GRISWOLD RD. & RIGHT-A-WAY LINE OF LAKE AVE.

NO. 00840

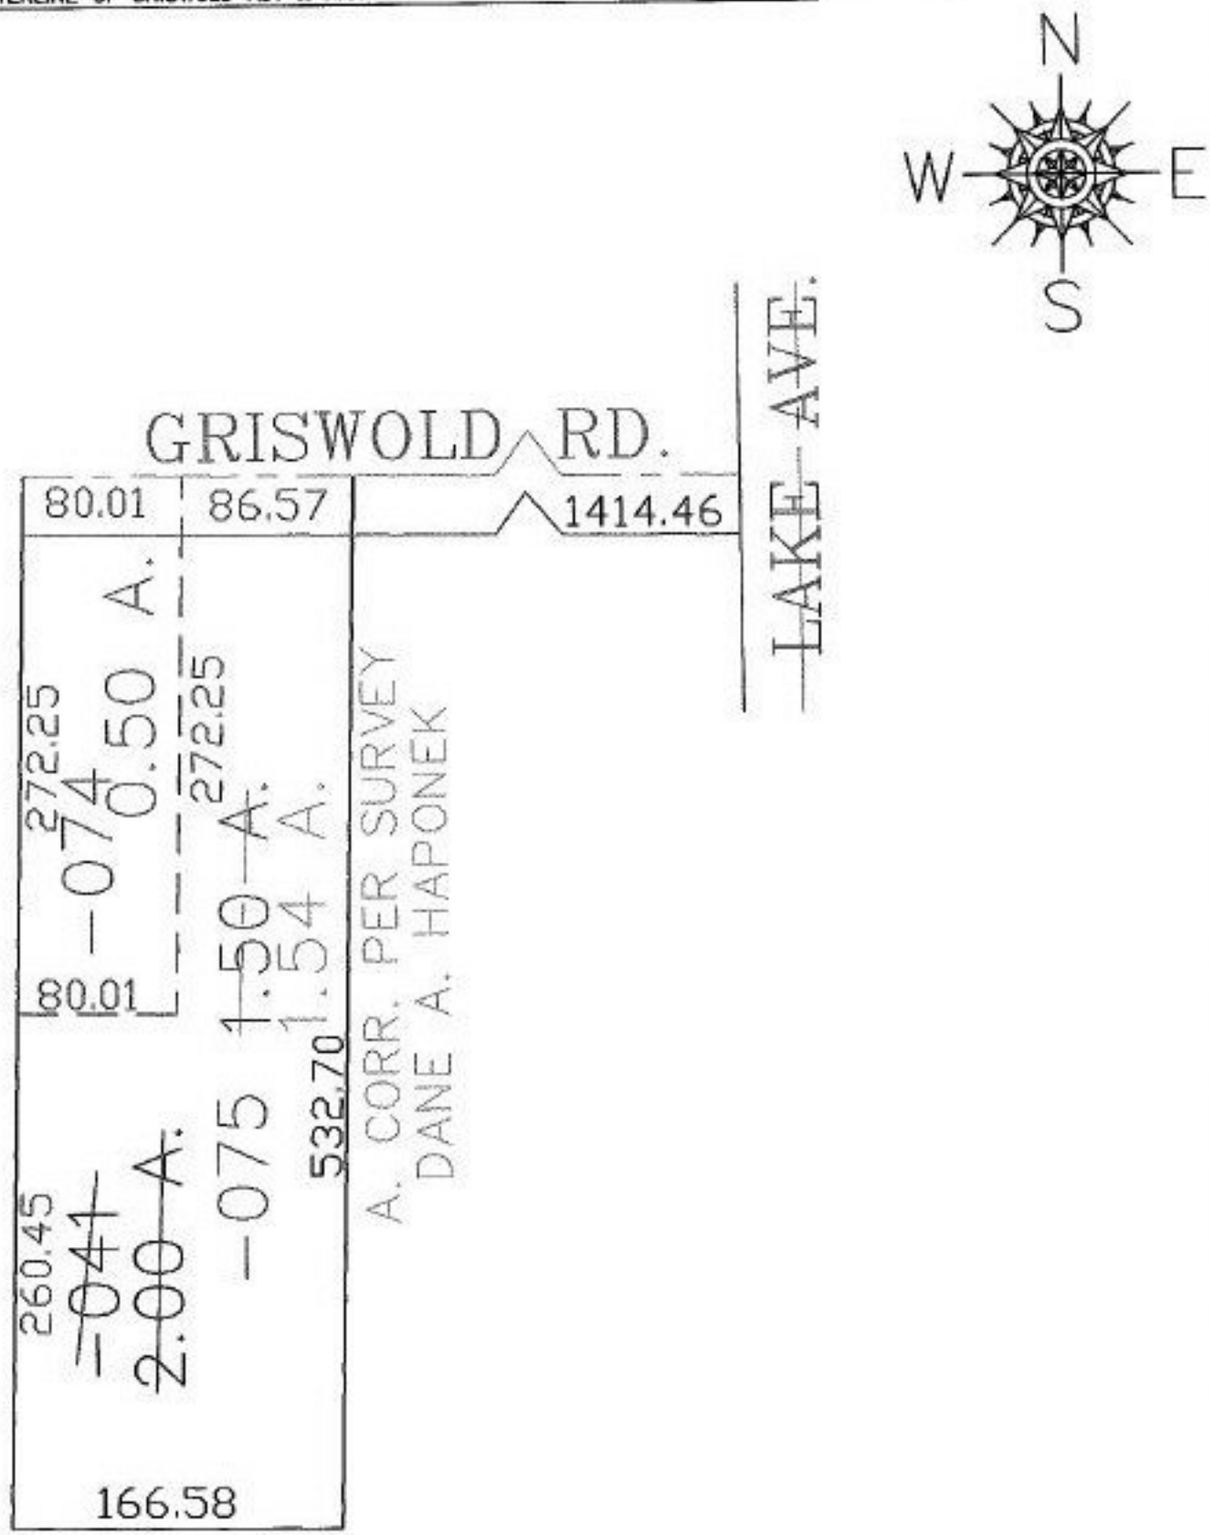

SPLITS/DEEDS PROCESSED

LORAIN COUNTY TAX MAP DEPARTMENT
226 MIDDLE AVE. ELYRIA, OHIO

SURVEYED BY: DANE A. HOPONEK
CLOSURE: 0.00 : 10,000
MAP PAGE(S): 6-41
APPROVED BY: JAH DATE: 8-13-01
SCALE: 1" = 100 PRIOR INSTRUMENT: 20000695170