RASTER

PARENT PARCEL: 10-00-005-102-425 THRU -429
CHILD PARCEL: 10-00-005-102-451 THRU -460
STARTING POINT: INTERSECTION OF DEFIANCE AVE. & OAKDALE CR.

NO. 00864

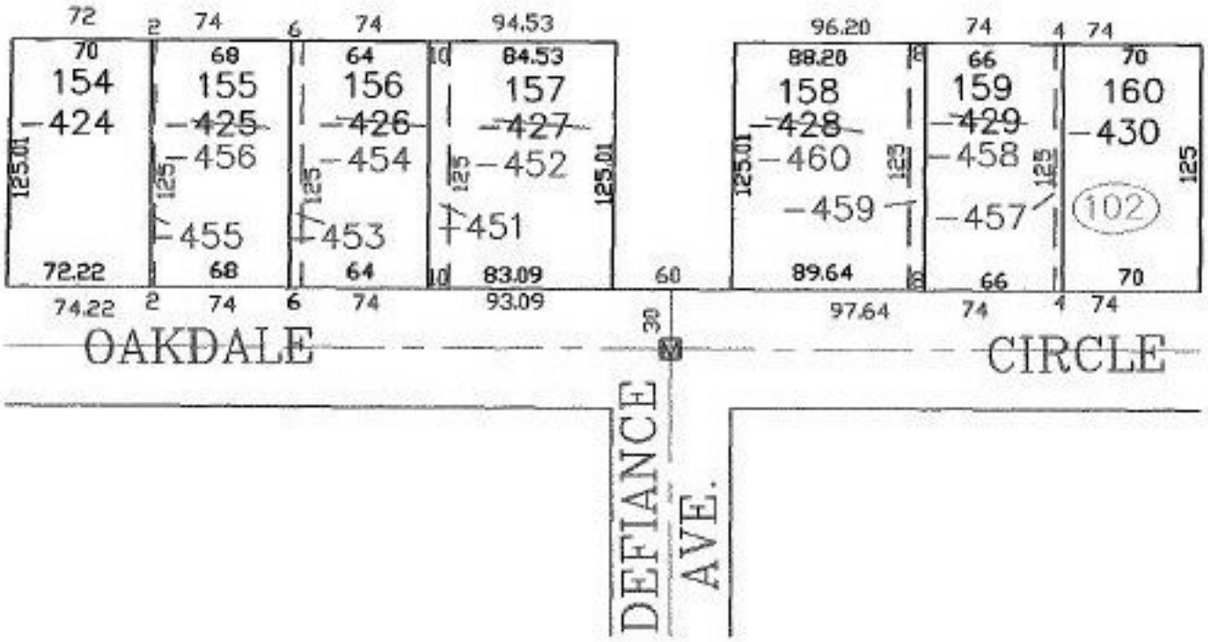


SPLITS/DEEDS PROCESSED

LORAIN COUNTY TAX MAP DEPARTMENT
226 MIDDLE AVE. ELYRIA, OHIO

SURVEYED BY: DAVID L. ELWELL
CLOSURE: 0.00 : 10,000
MAP PAGE(S): 10-00-005-D
APPROVED BY: JAH DATE: 9-27-01
SCALE: 1" = 100 PRIOR INSTRUMENT: PV 66/36