RASTER

PARENT PARCEL: 02-01-003-119-020

CHILD PARCEL: 02-01-003-119-021, -022 02-01-004-101-077, -078

STARTING POINT: CENTERLINE OF 8TH ST. & BROADWAY AVE.

NO. 00875

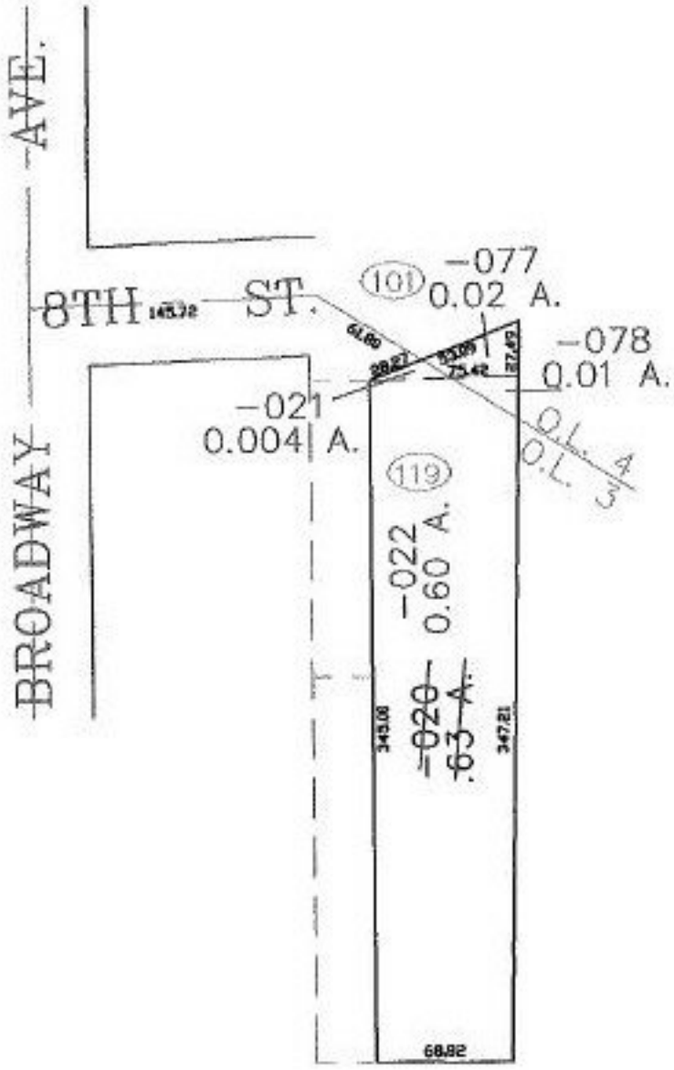

SPLITS/DEEDS PROCESSED

LORAIN COUNTY TAX MAP DEPARTMENT
226 MIDDLE AVE. ELYRIA, OHIO

SURVEYED BY: DAVE L. ELWELL

CLOSURE: 0.00 : 10,000

MAP PAGE(S): 02-01-003-C

APPROVED BY: JAH DATE: 09-20-01

SCALE: 1"= 100 PRIOR INSTRUMENT: OR 243/858