RASTER

PARENT PARCEL: 14-00-148-000-019
CHILD PARCEL: 14-00-148-000-026 THRU -030
STARTING POINT: CENTERLINE OF MERRIAM RD. & PITTS RD.

NO. 00887

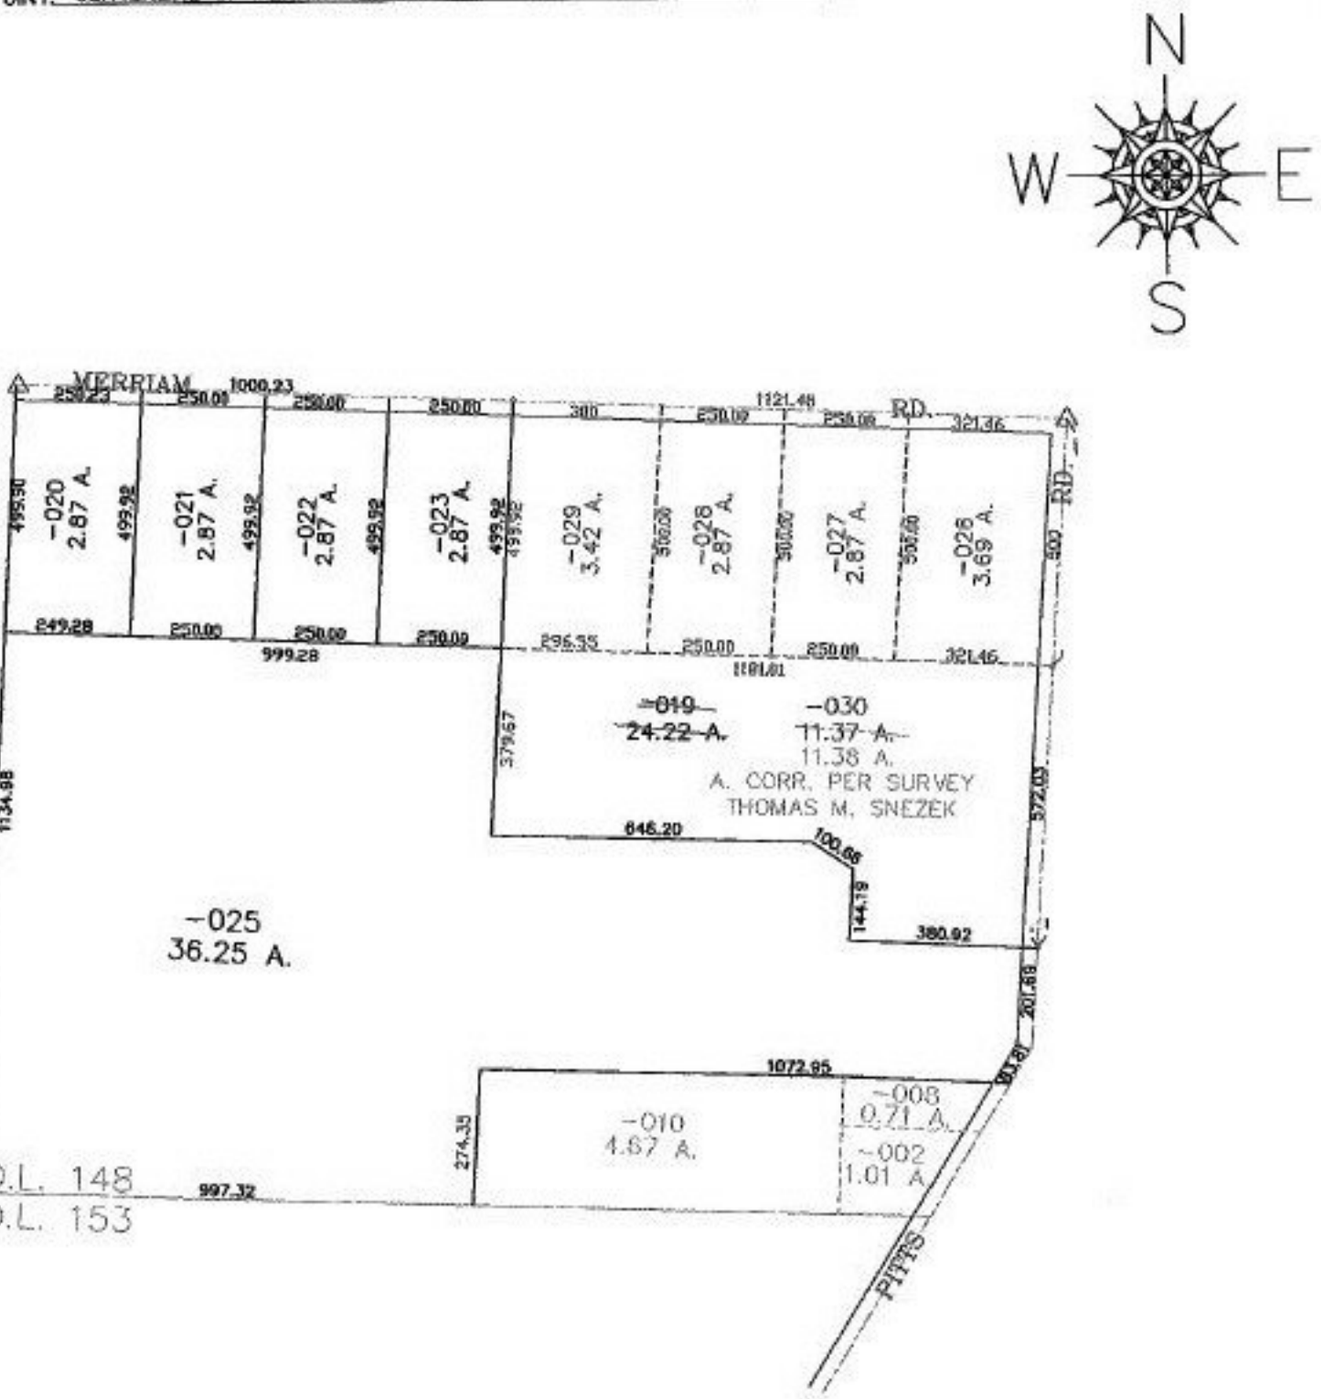

SPLITS/DEEDS PROCESSED
LORAIN COUNTY TAX MAP DEPARTMENT
226 MIDDLE AVE. ELYRIA, OHIO

SURVEYED BY: THOMAS M. SNEZEK
CLOSURE: 0.00 : 10,000
MAP PAGE(S): 14-F
APPROVED BY: JAH DATE: 10-3-01
SCALE: 1" = 400 PRIOR INSTRUMENT: OR 1142/410