RASTER

PARENT PARCEL: 21-08-005-000-001, 21-08-006-000-001

CHILD PARCEL: 21-08-005-000-002 THRU 010 & 21-08-006-000-002 THRU -011

STARTING POINT: CENTERLINE OF WEST RD. & NEW LONDON-EASTERN RD.

NO. 00907

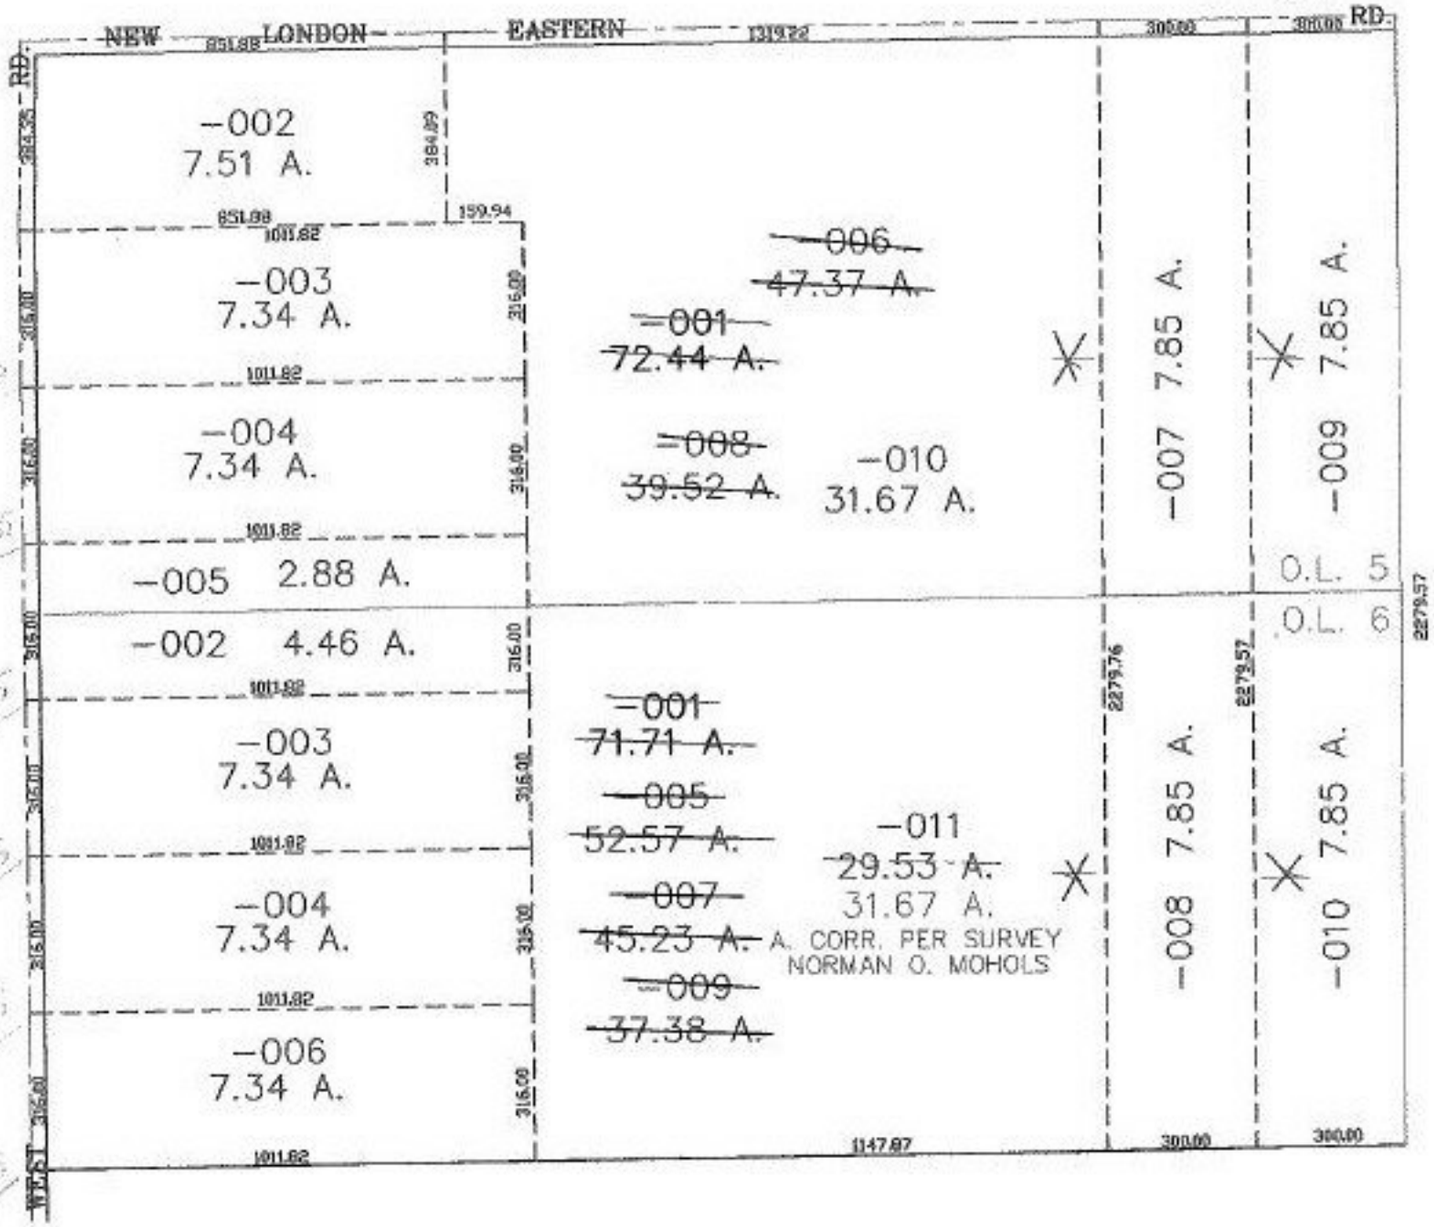

SPLITS/DEEDS PROCESSED

LORAIN COUNTY TAX MAP DEPARTMENT
226 MIDDLE AVE. ELYRIA, OHIO

SURVEYED BY: NORMAN O. MOHOLS

CLOSURE: 0.00 : 10.000

MAP PAGE(S): 21-H

APPROVED BY: JAH DATE: 11-2-01

SCALE: 1"= 400 PRIOR INSTRUMENT: DV 1099/29