RASTER

PARENT PARCEL: 03-00-063-000-042, -064, -066
CHILD PARCEL: 03-00-063-000-067 THRU -069
STARTING POINT: NORTHWEST CORNER OF MARCUS DR.

NO. 00916

N
W E
S

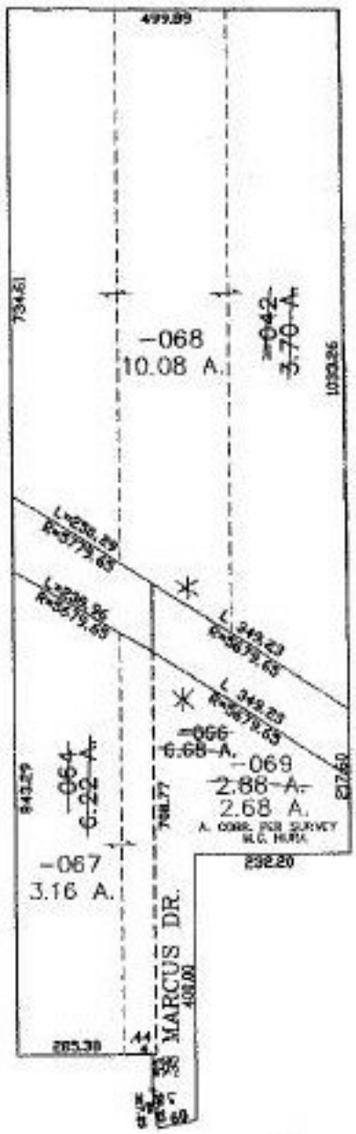

SPLITS/DEEDS PROCESSED
LORAIN COUNTY TAX MAP DEPARTMENT
226 MIDDLE AVE. ELYRIA, OHIO

SURVEYED BY: M.G. HURA
CLOSURE: 0.00 : 10.000
MAP PAGE(S): 03-00-063
APPROVED BY: JAH DATE: 12-20-01
SCALE: 1"= 300 PRIOR INSTRUMENT: OR 643/305