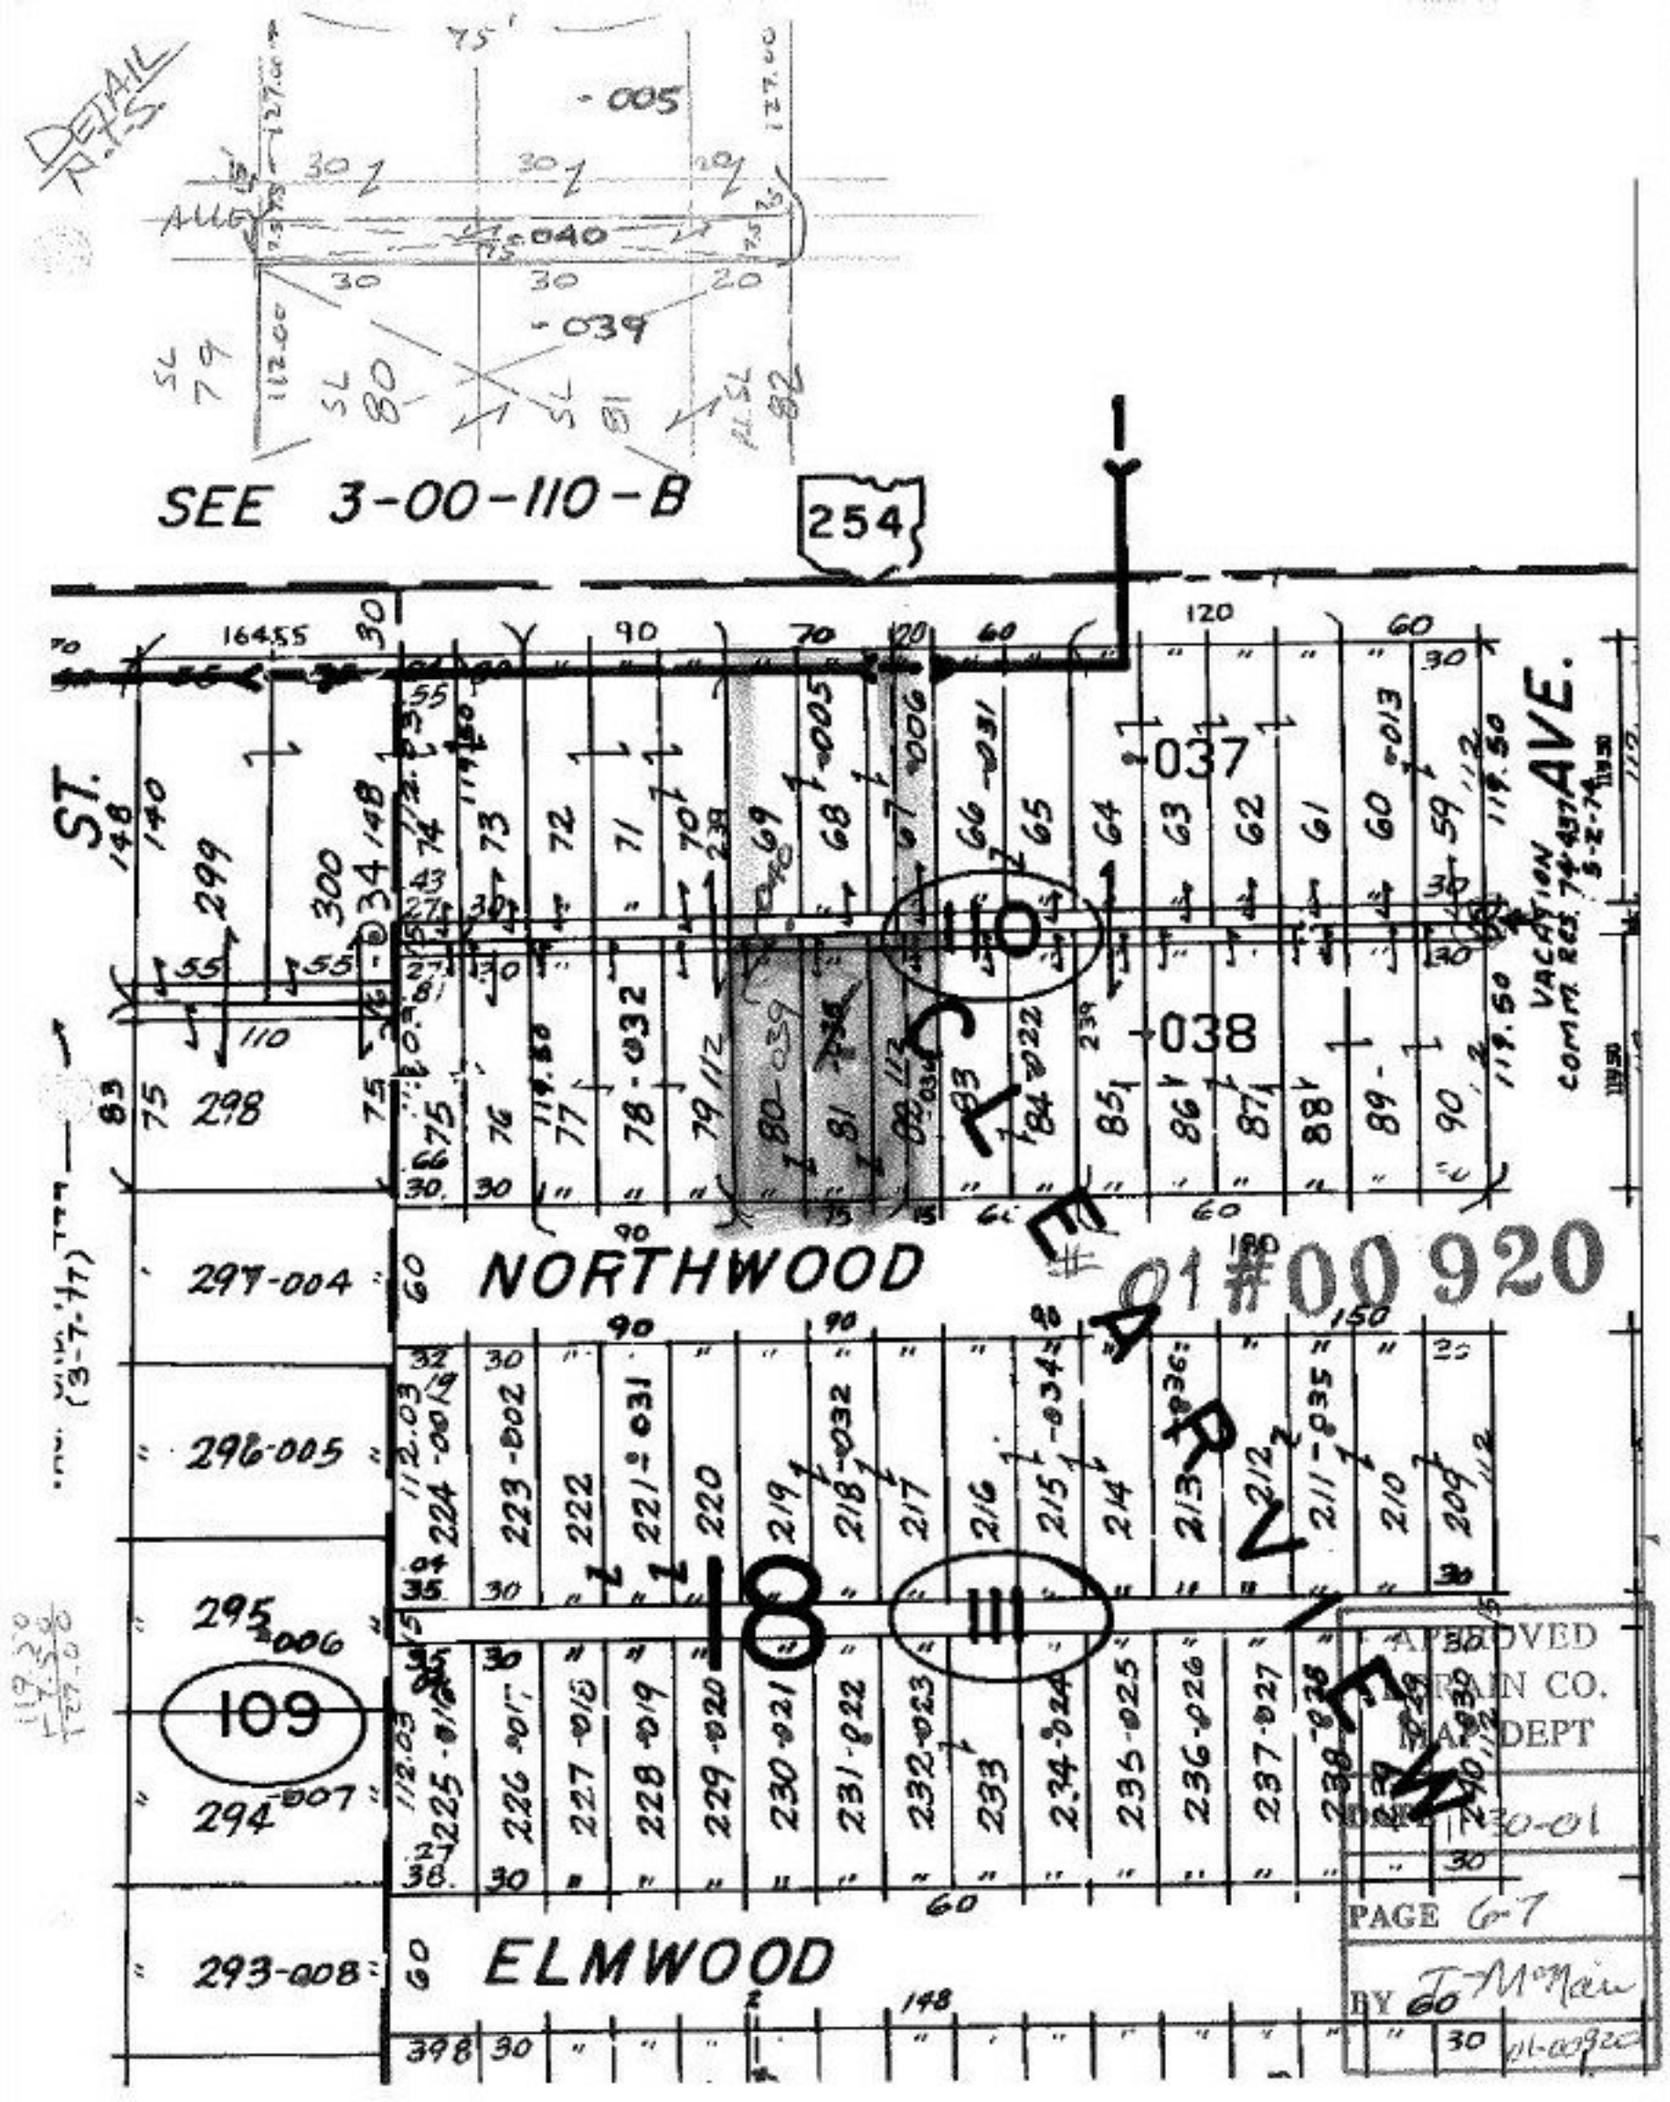
DETAIL N.T.S.
SEE 3-00-110-B
254
ST.
AVE.
NORTHWOOD
ELMWOOD
CLEARVIEW
VACATION COMM. RES. 74-437 5-2-74
01#00920
APPROVED
LORAIN CO.
MAP DEPT
DATE 1-30-01
PAGE 6-7
BY J. McNair
01-00920