RASTER

PARENT PARCEL: 19-03-013-000-020, -019, 19-03-014-000-017
CHILD PARCEL: 19-03-013-000-021, -022 19-03-014-000-018, -019 19-03-015-000-035
STARTING POINT: CENTERLINE OF MEDINA NORWALK RD. & LAGRANGE RD.

NO. 00943

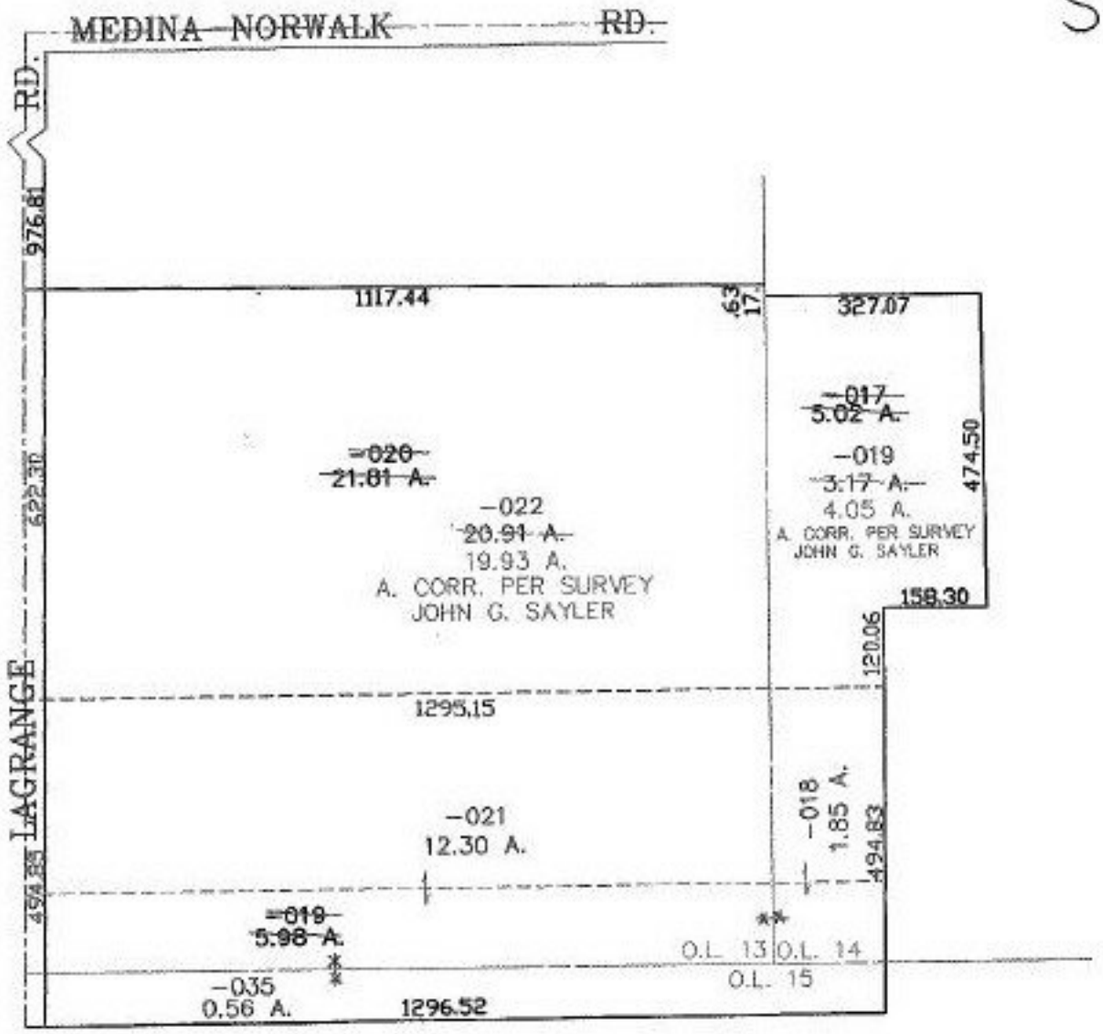

SPLITS/DEEDS PROCESSED
LORAIN COUNTY TAX MAP DEPARTMENT
226 MIDDLE AVE. ELYRIA, OHIO

SURVEYED BY: JOHN G. SAYLOR
CLOSURE: 0.00 : 10,000
MAP PAGE(S): 19-03-014-G
APPROVED BY: JAH DATE: 12-19-01
SCALE: 1" = 300 PRIOR INSTRUMENT: 20010781860