RASTER

PARENT PARCEL: 15-00-024-000-035,-029
CHILD PARCEL: 15-00-024-000-036 THRU -041
STARTING POINT: INTERSECTION OF C/L OF WHITEHEAD RD. AND NORTHWEST CORNER OF O.L. 24

NO. 00949

RODAK SUB.
VOL. 61 PG. 30

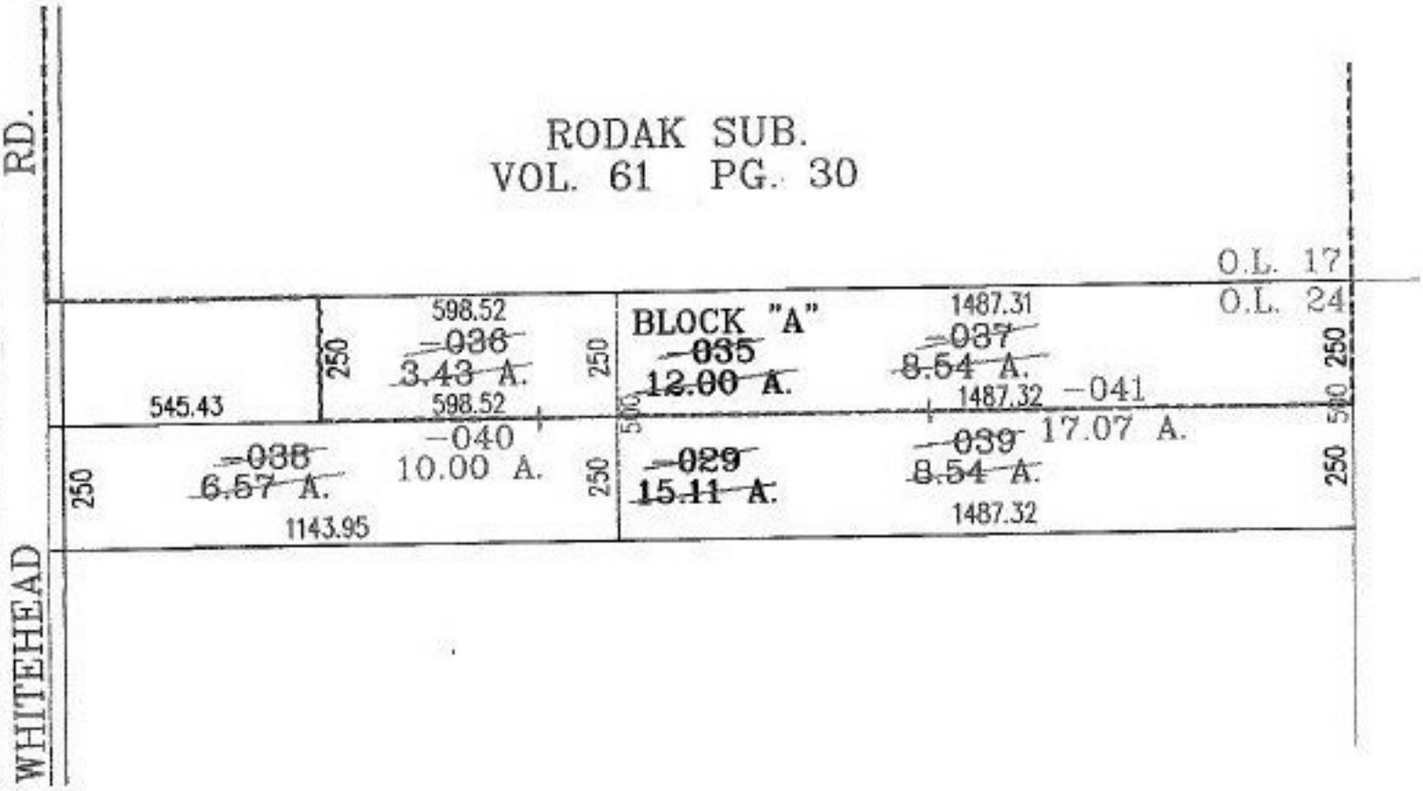

SPLITS/DEEDS PROCESSED
LORAIN COUNTY TAX MAP DEPARTMENT
226 MIDDLE AVE. ELYRIA, OHIO

SURVEYED BY: A.KELSER
CLOSURE: .16:10,000
MAP PAGE(S): 15-8
APPROVED BY: RRM DATE: 12-26-01
SCALE: 1"= 400 PRIOR INSTRUMENT: 980578787