RASTER

PARENT PARCEL: 16-00-021-000-025

CHILD PARCEL: 16-00-021-000-029, -030

STARTING POINT: CENTERLINE OF CHAMBERLAIN RD. & O.L. 21

NO. 00951

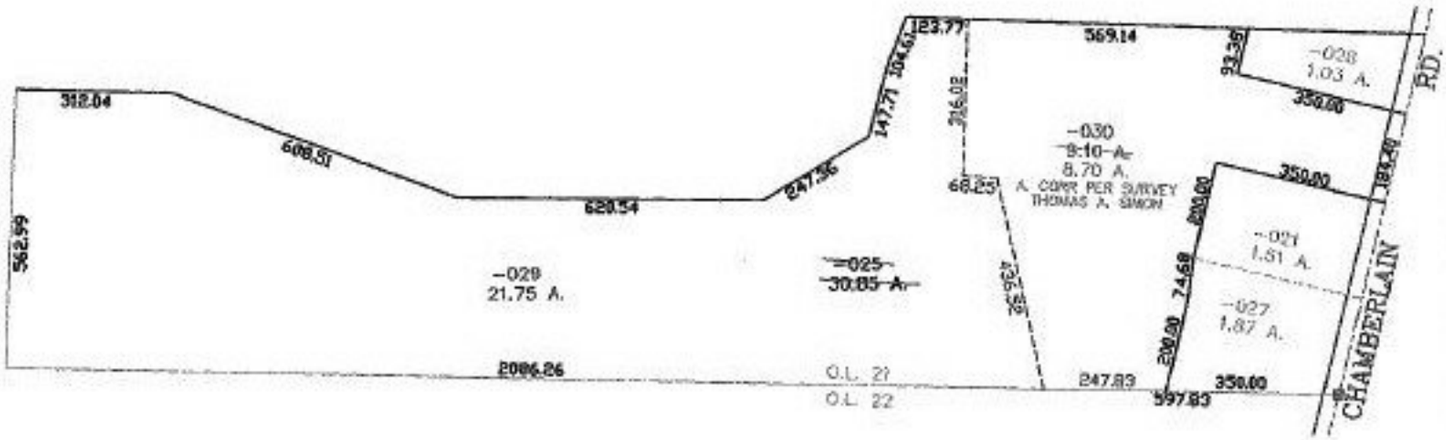

SPLITS/DEEDS PROCESSED

LORAIN COUNTY TAX MAP DEPARTMENT

226 MIDDLE AVE. ELYRIA, OHIO

SURVEYED BY: THOMAS A. SIMON

CLOSURE: 0.00 : 10.000

MAP PAGE(S): 16-A

APPROVED BY: JAH DATE: 12-27-01

SCALE: 1" = 400 PRIOR INSTRUMENT: OR 906/593