PARENT PARCEL: 06-23-003-102-001

CHILD PARCEL: 06-23-003-102-059, -060, -061, -062

STARTING POINT: INT OF N ROW CRESTLANE DR E ROW OF EL CAMINO CT

NO. 01013-V

ST VAC
RES NO
03-539

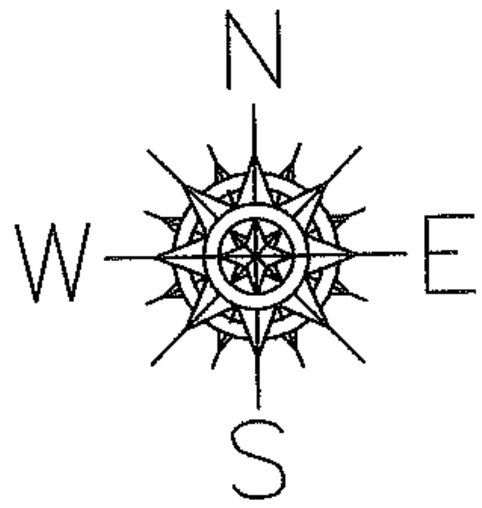

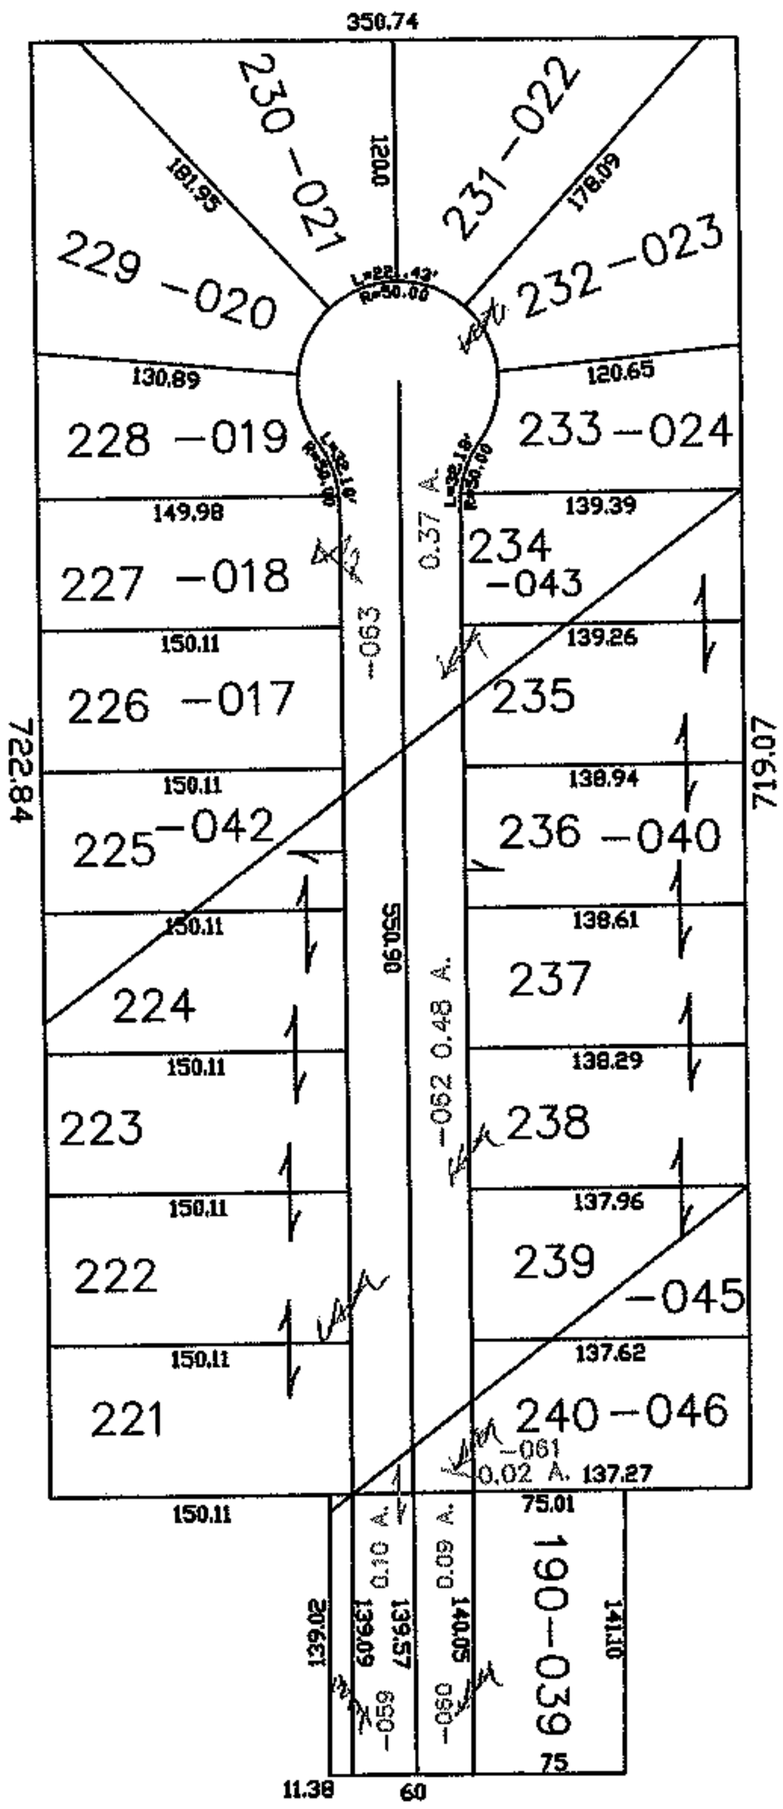

06-23-003-900-002
NEED TO DROP

TAPE OUT
HOOKS

-040
NEEDS AC. CORR.

SPLITS/DEEDS PROCESSED

LORAIN COUNTY TAX MAP DEPARTMENT
226 MIDDLE AVE. ELYRIA, OHIO

SURVEYED BY: N/A

CLOSURE: N/A

MAP PAGE(S): 6-38, 6-39

APPROVED BY: DRH DATE: 5/26/2004

SCALE: 1"= 150 PRIOR INSTRUMENT: RES 03-539