EASTER

PARENT PARCEL: 11-00-004-000-010

CHILD PARCEL: --SAME--

STARTING POINT: SE CORNER OF O.L. 4

NO. 01017-A

N

W E

S

SIZE CORR

PER DEED

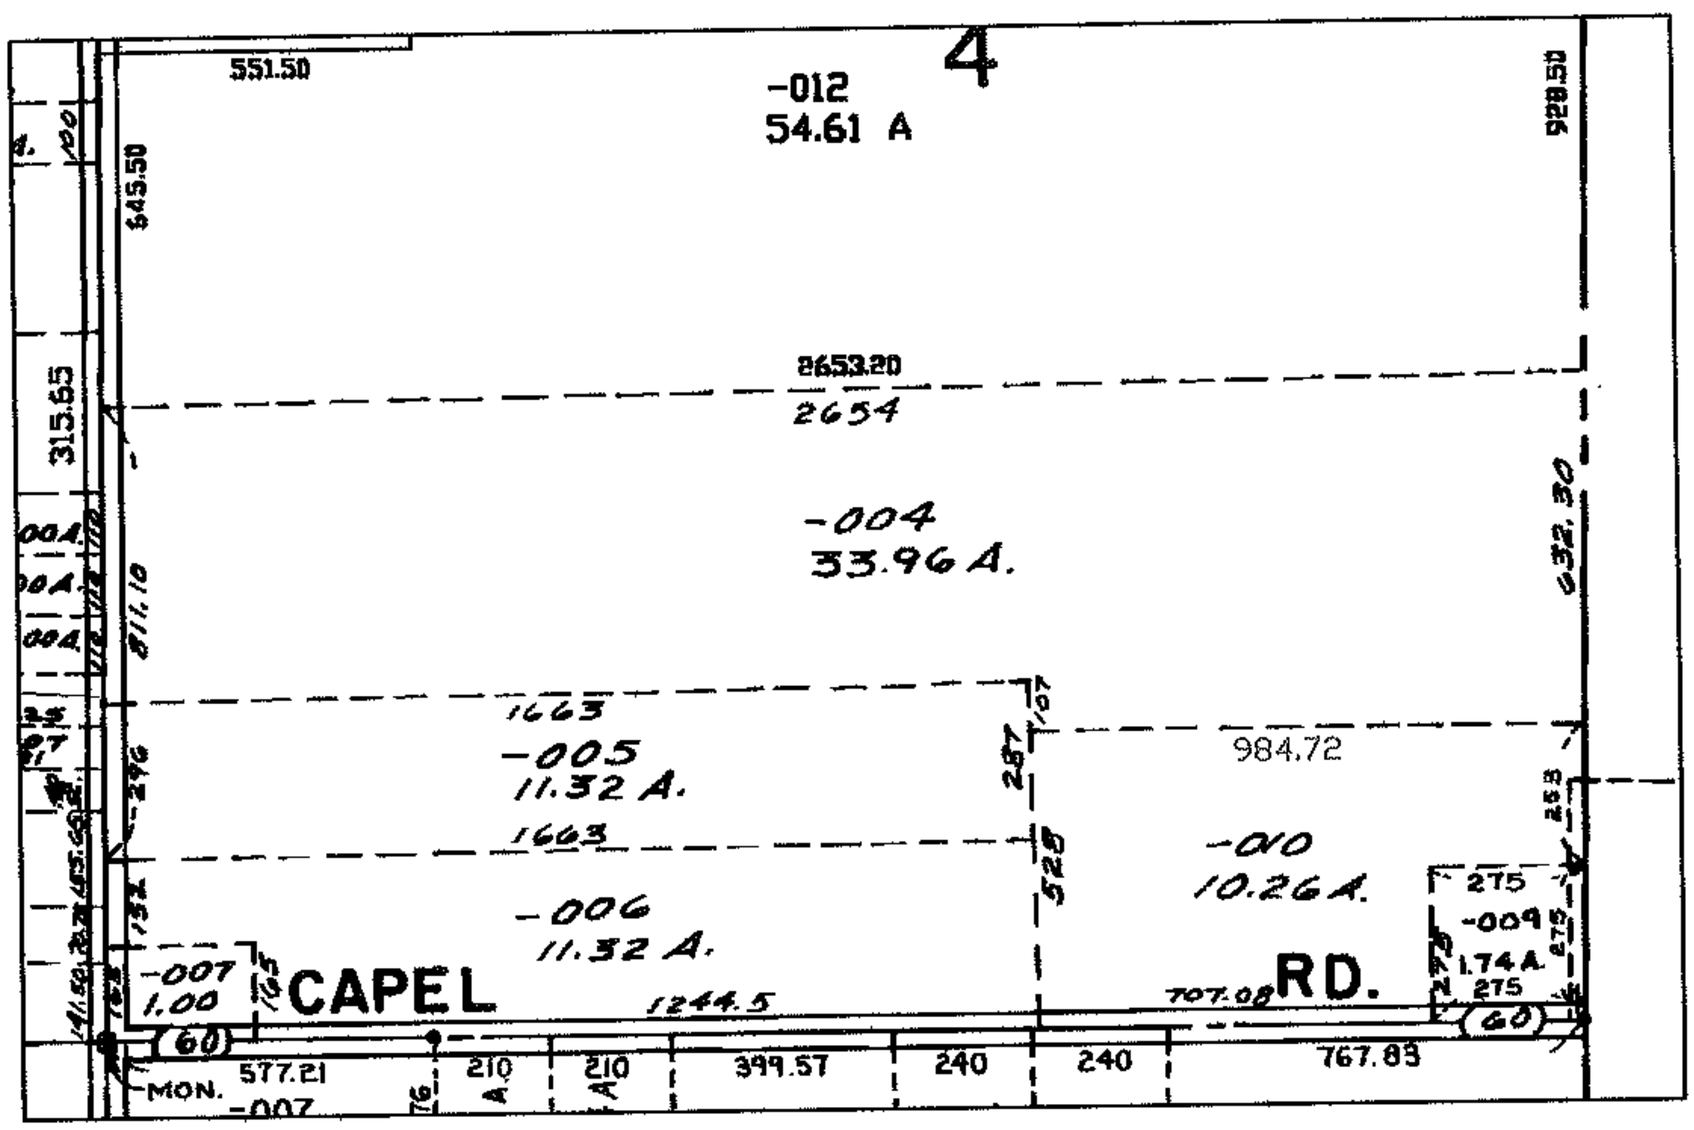

SPLITS/DEEDS PROCESSED

LORAIN COUNTY TAX MAP DEPARTMENT
226 MIDDLE AVE. ELYRIA, OHIO

SURVEYED BY: N/A

CLOSURE: N/A

MAP PAGE(S): 11-H

APPROVED BY: DRH DATE: 6/10/2004

SCALE: 1"= 200 PRIOR INSTRUMENT: DV 963/773