EASTER

PARENT PARCEL: 02-01-004-103-012

CHILD PARCEL:

STARTING POINT:

NO. 01039-X

DEPTH CORR PER PLAT

N

W E

S

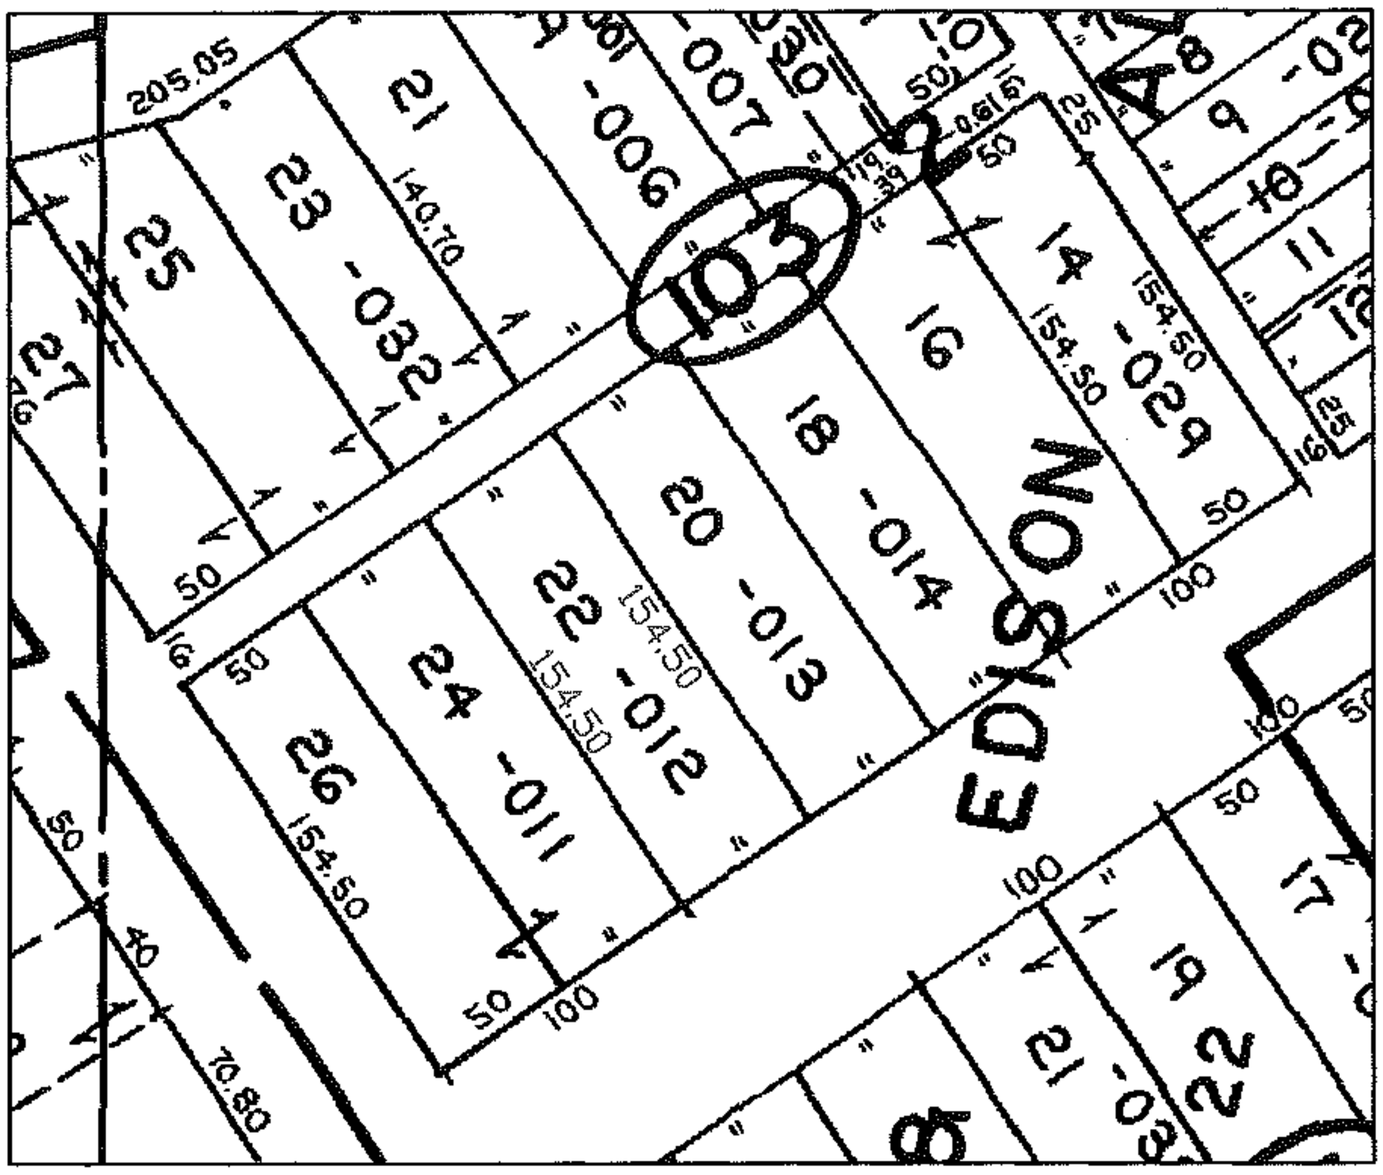

NOT TO SCALE

SPLITS/DEEDS PROCESSED

LORAIN COUNTY TAX MAP DEPARTMENT
226 MIDDLE AVE. ELYRIA, OHIO

SURVEYED BY:

CLOSURE:

MAP PAGE(S): 02-01-004-B

APPROVED BY: DRH DATE: 8/30/2004

SCALE: 1"= 100 PRIOR INSTRUMENT: