RASTER

PARENT PARCEL: 04-00-030-147-010
CHILD PARCEL: 04-00-030-147-067, -068
STARTING POINT:

NO. 01040-X

UNCOMBINATION

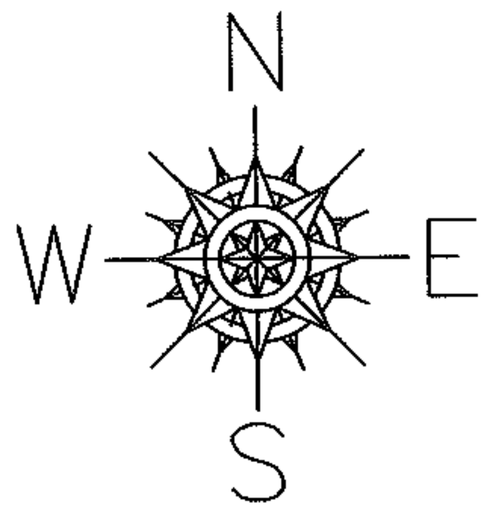

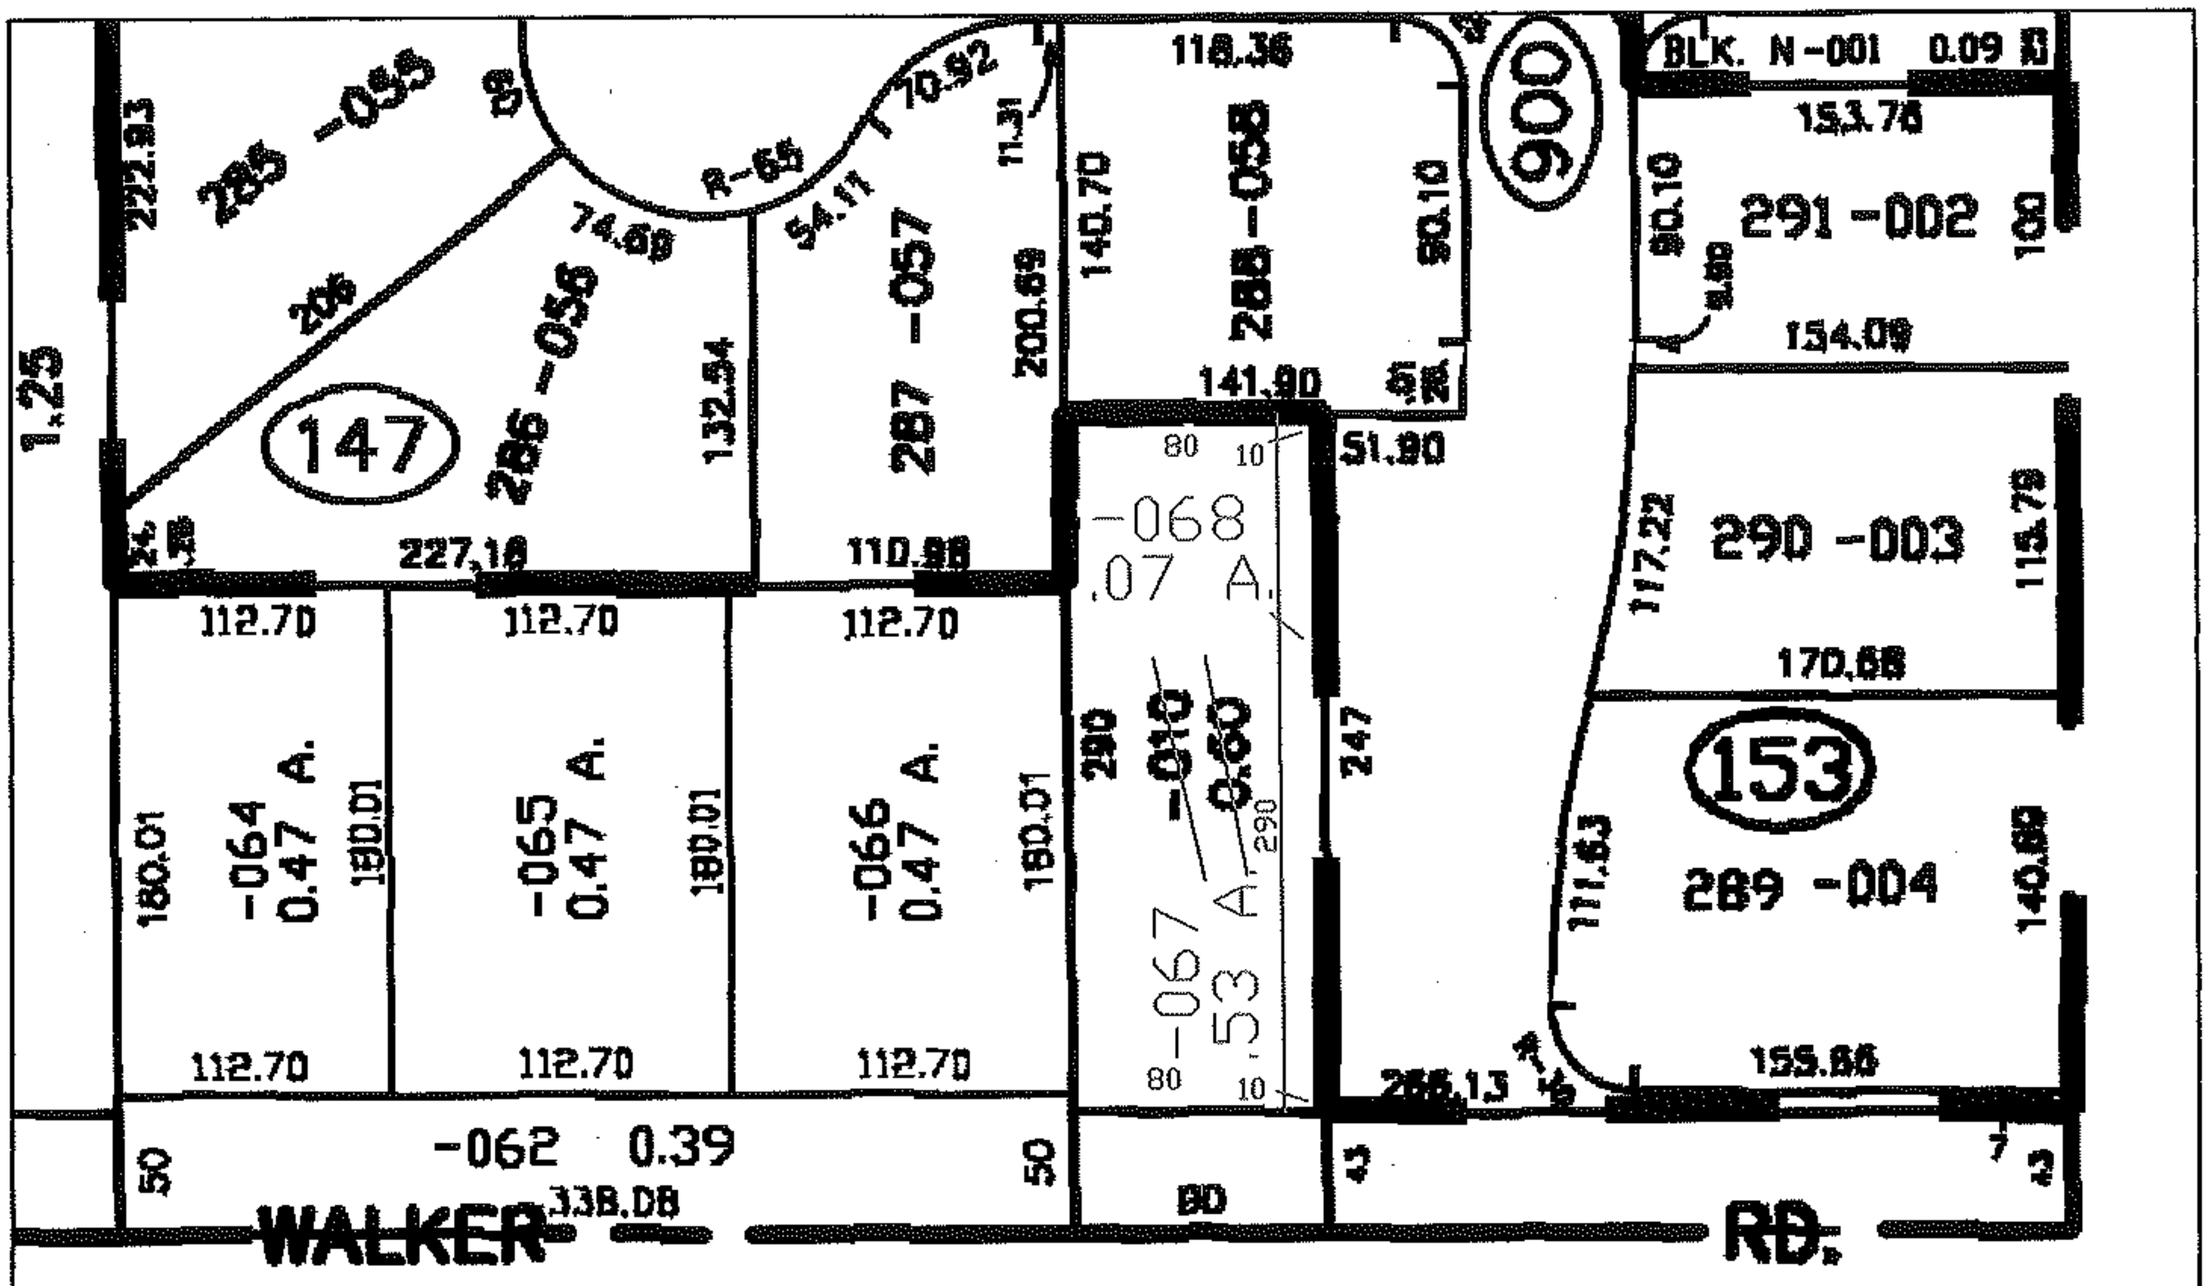

SEE 4-00-029-C

SPLITS/DEEDS PROCESSED

LORAIN COUNTY TAX MAP DEPARTMENT
226 MIDDLE AVE. ELYRIA, OHIO

SURVEYED BY:
CLOSURE:
MAP PAGE(S): 04-00-030-G
APPROVED BY: DRH DATE: 8/25/2004
SCALE: 1"= 50 PRIOR INSTRUMENT: