RASTER

PARENT PARCEL: 15-00-091-000-020 & 15-00-092-000-006

PARENT PARCEL: 19-06-040-000-020, 19-06-041-000-003 &004, 19-06-042-000-008

PARENT PARCEL: 19-06-043-000-004

CHILD PARCEL: 15-00-091-000-020 & 15-00-092-000-006

CHILD PARCEL: 19-06-040-000-020, 19-06-041-000-010, 19-06-042-000-008, 19-06-043-000-004

STARTING POINT: MON BOX INT CL OF SHORT RD AND VERMONT ST

NO. 01058-D

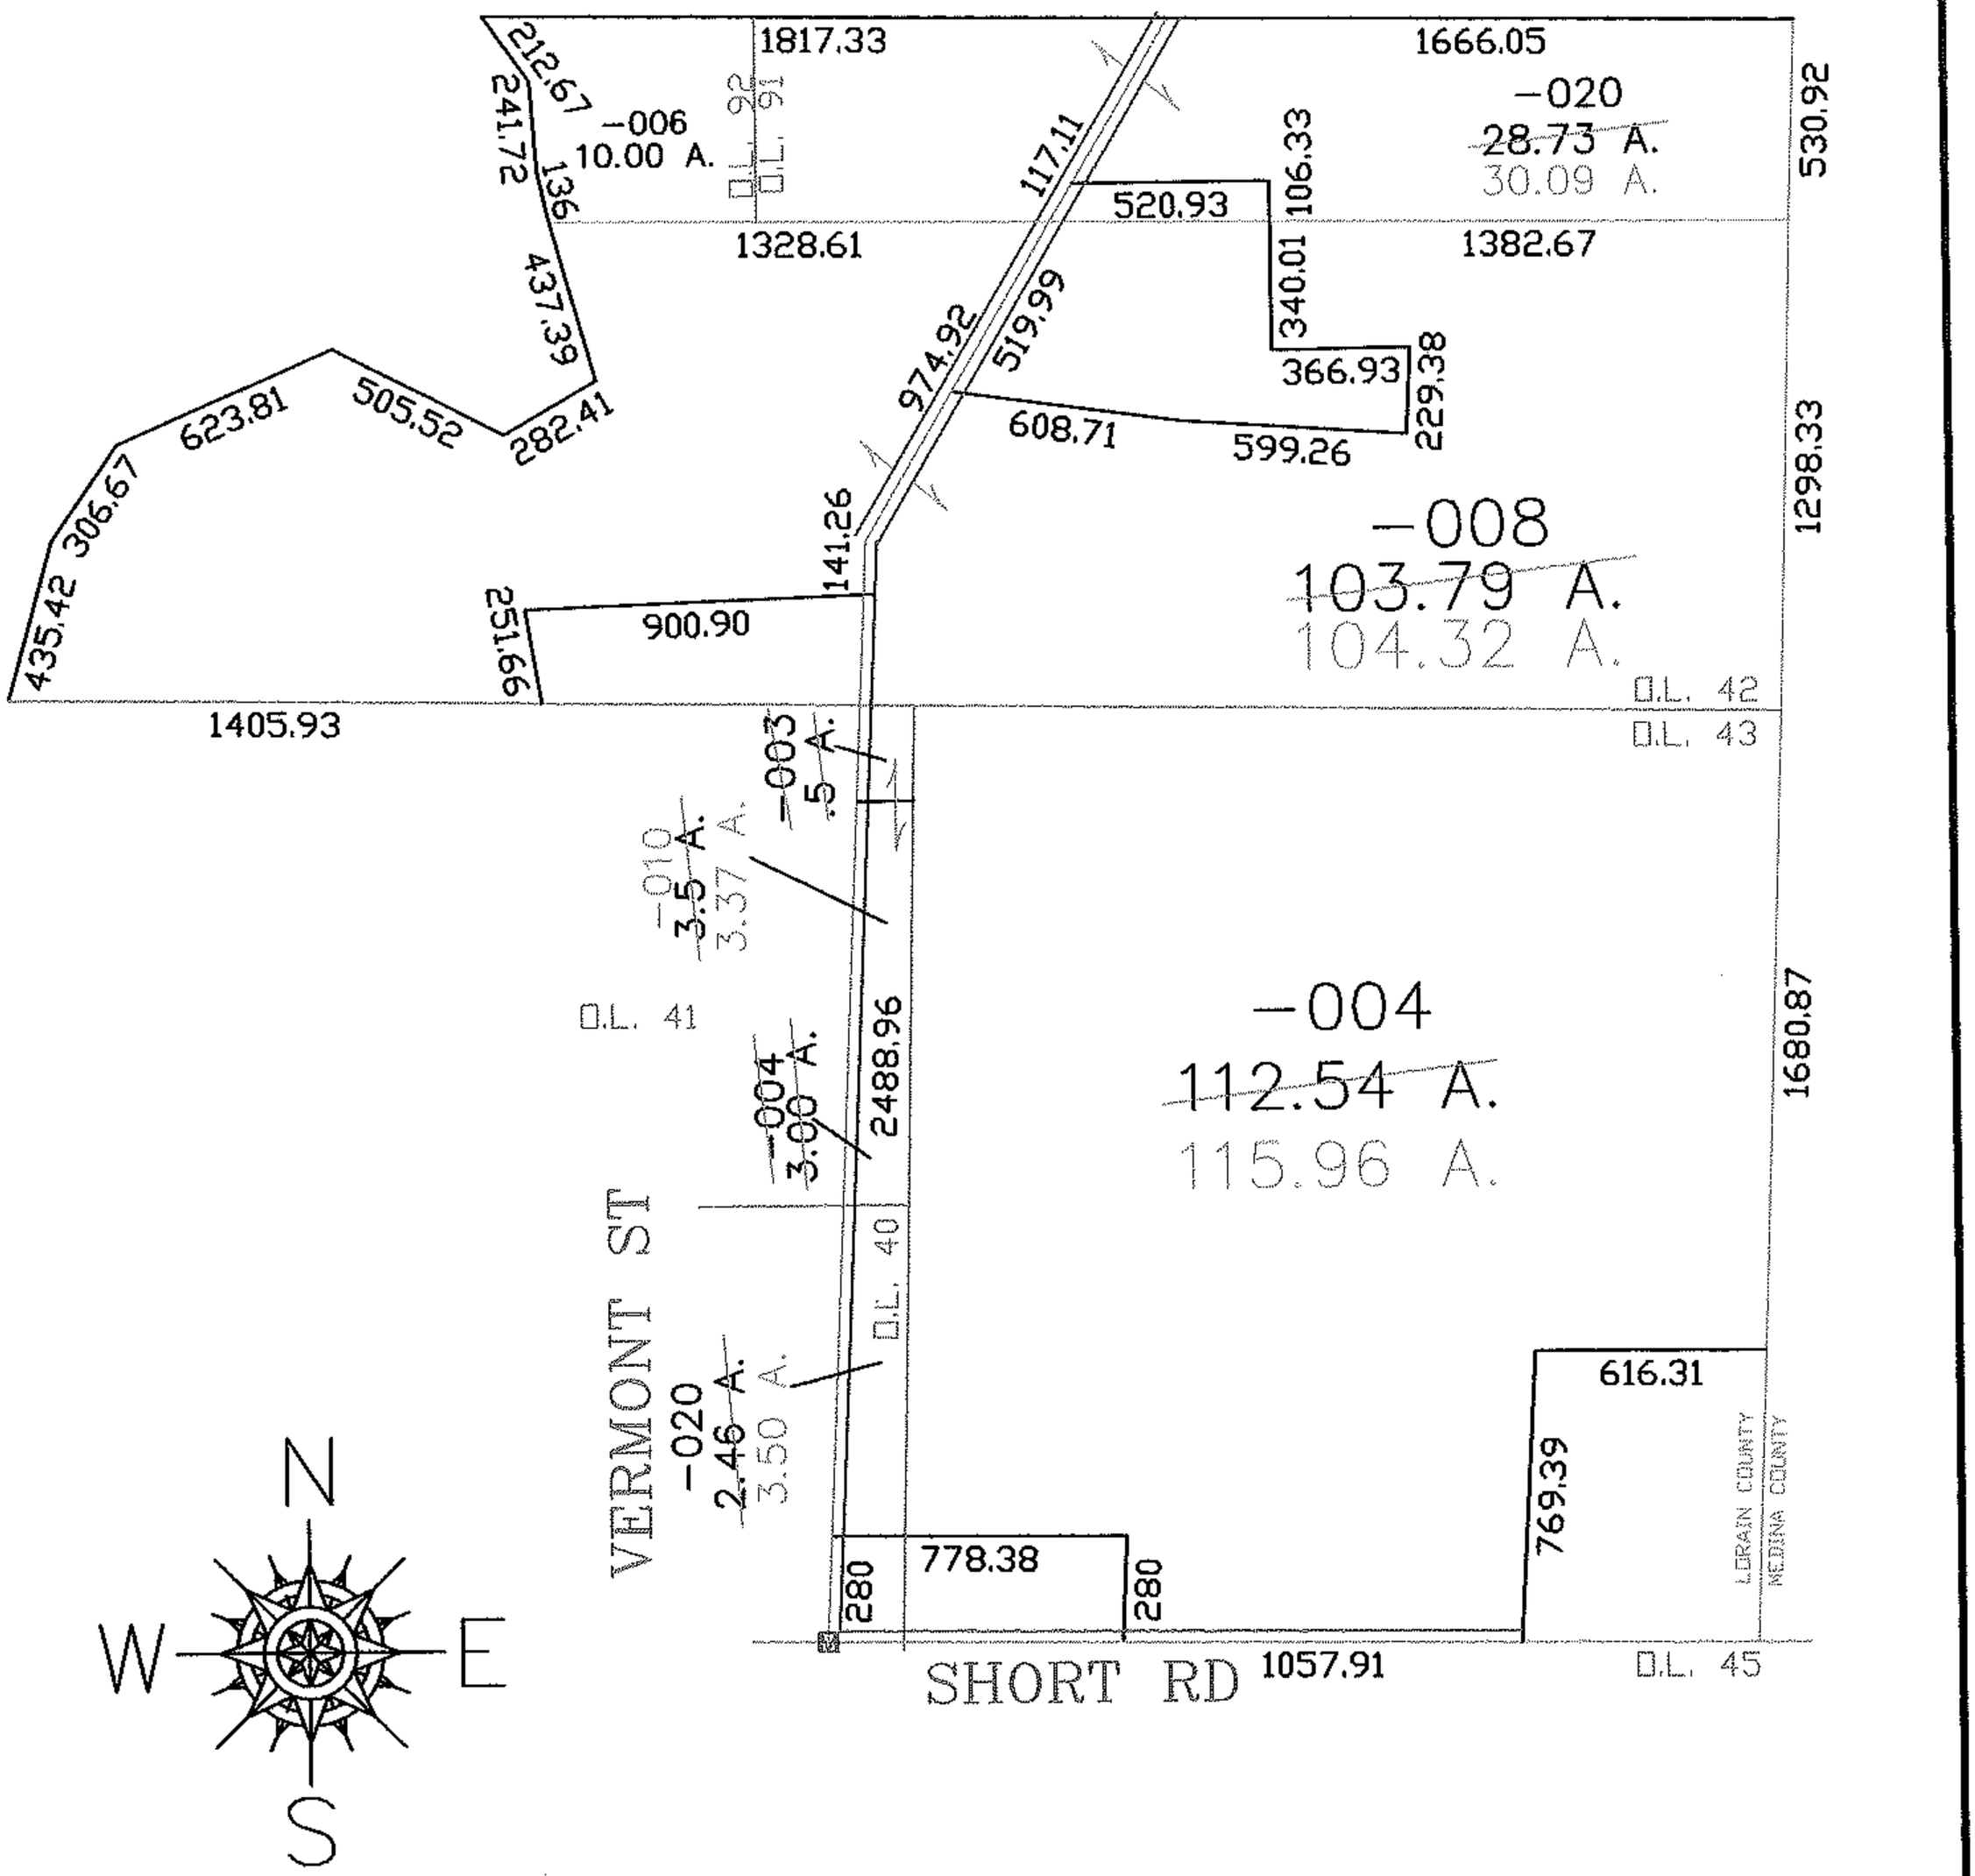

SPLITS/DEEDS PROCESSED

LORAIN COUNTY TAX MAP DEPARTMENT
226 MIDDLE AVE. ELYRIA, OHIO

SURVEYED BY: RICHARD D. CARLSON

CLOSURE: 1:10,000

MAP PAGE(S): 19-D & 15-H

APPROVED BY: DRH DATE: 9-27-2004

SCALE: 1"= 700 PRIOR INSTRUMENT: