RASTER

PARENT PARCEL: 03-00-032-107-058, 03-00-032-103-005, 04-00-006-105-035

CHILD PARCEL: --SAME--

STARTING POINT: INT CL WALKER RD TWP LINE BTWN AVON & SHEFFIELD

NO. 01103-C

NEW CORRECT

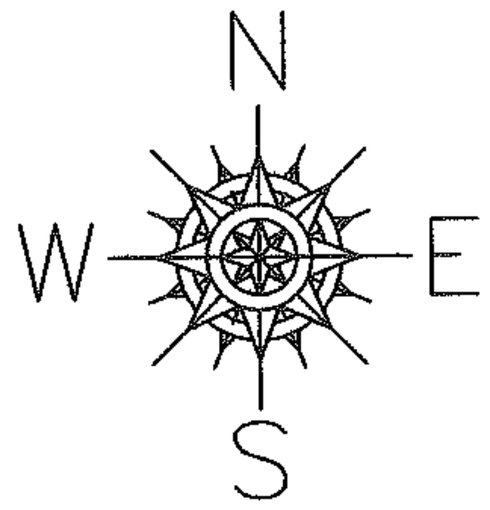

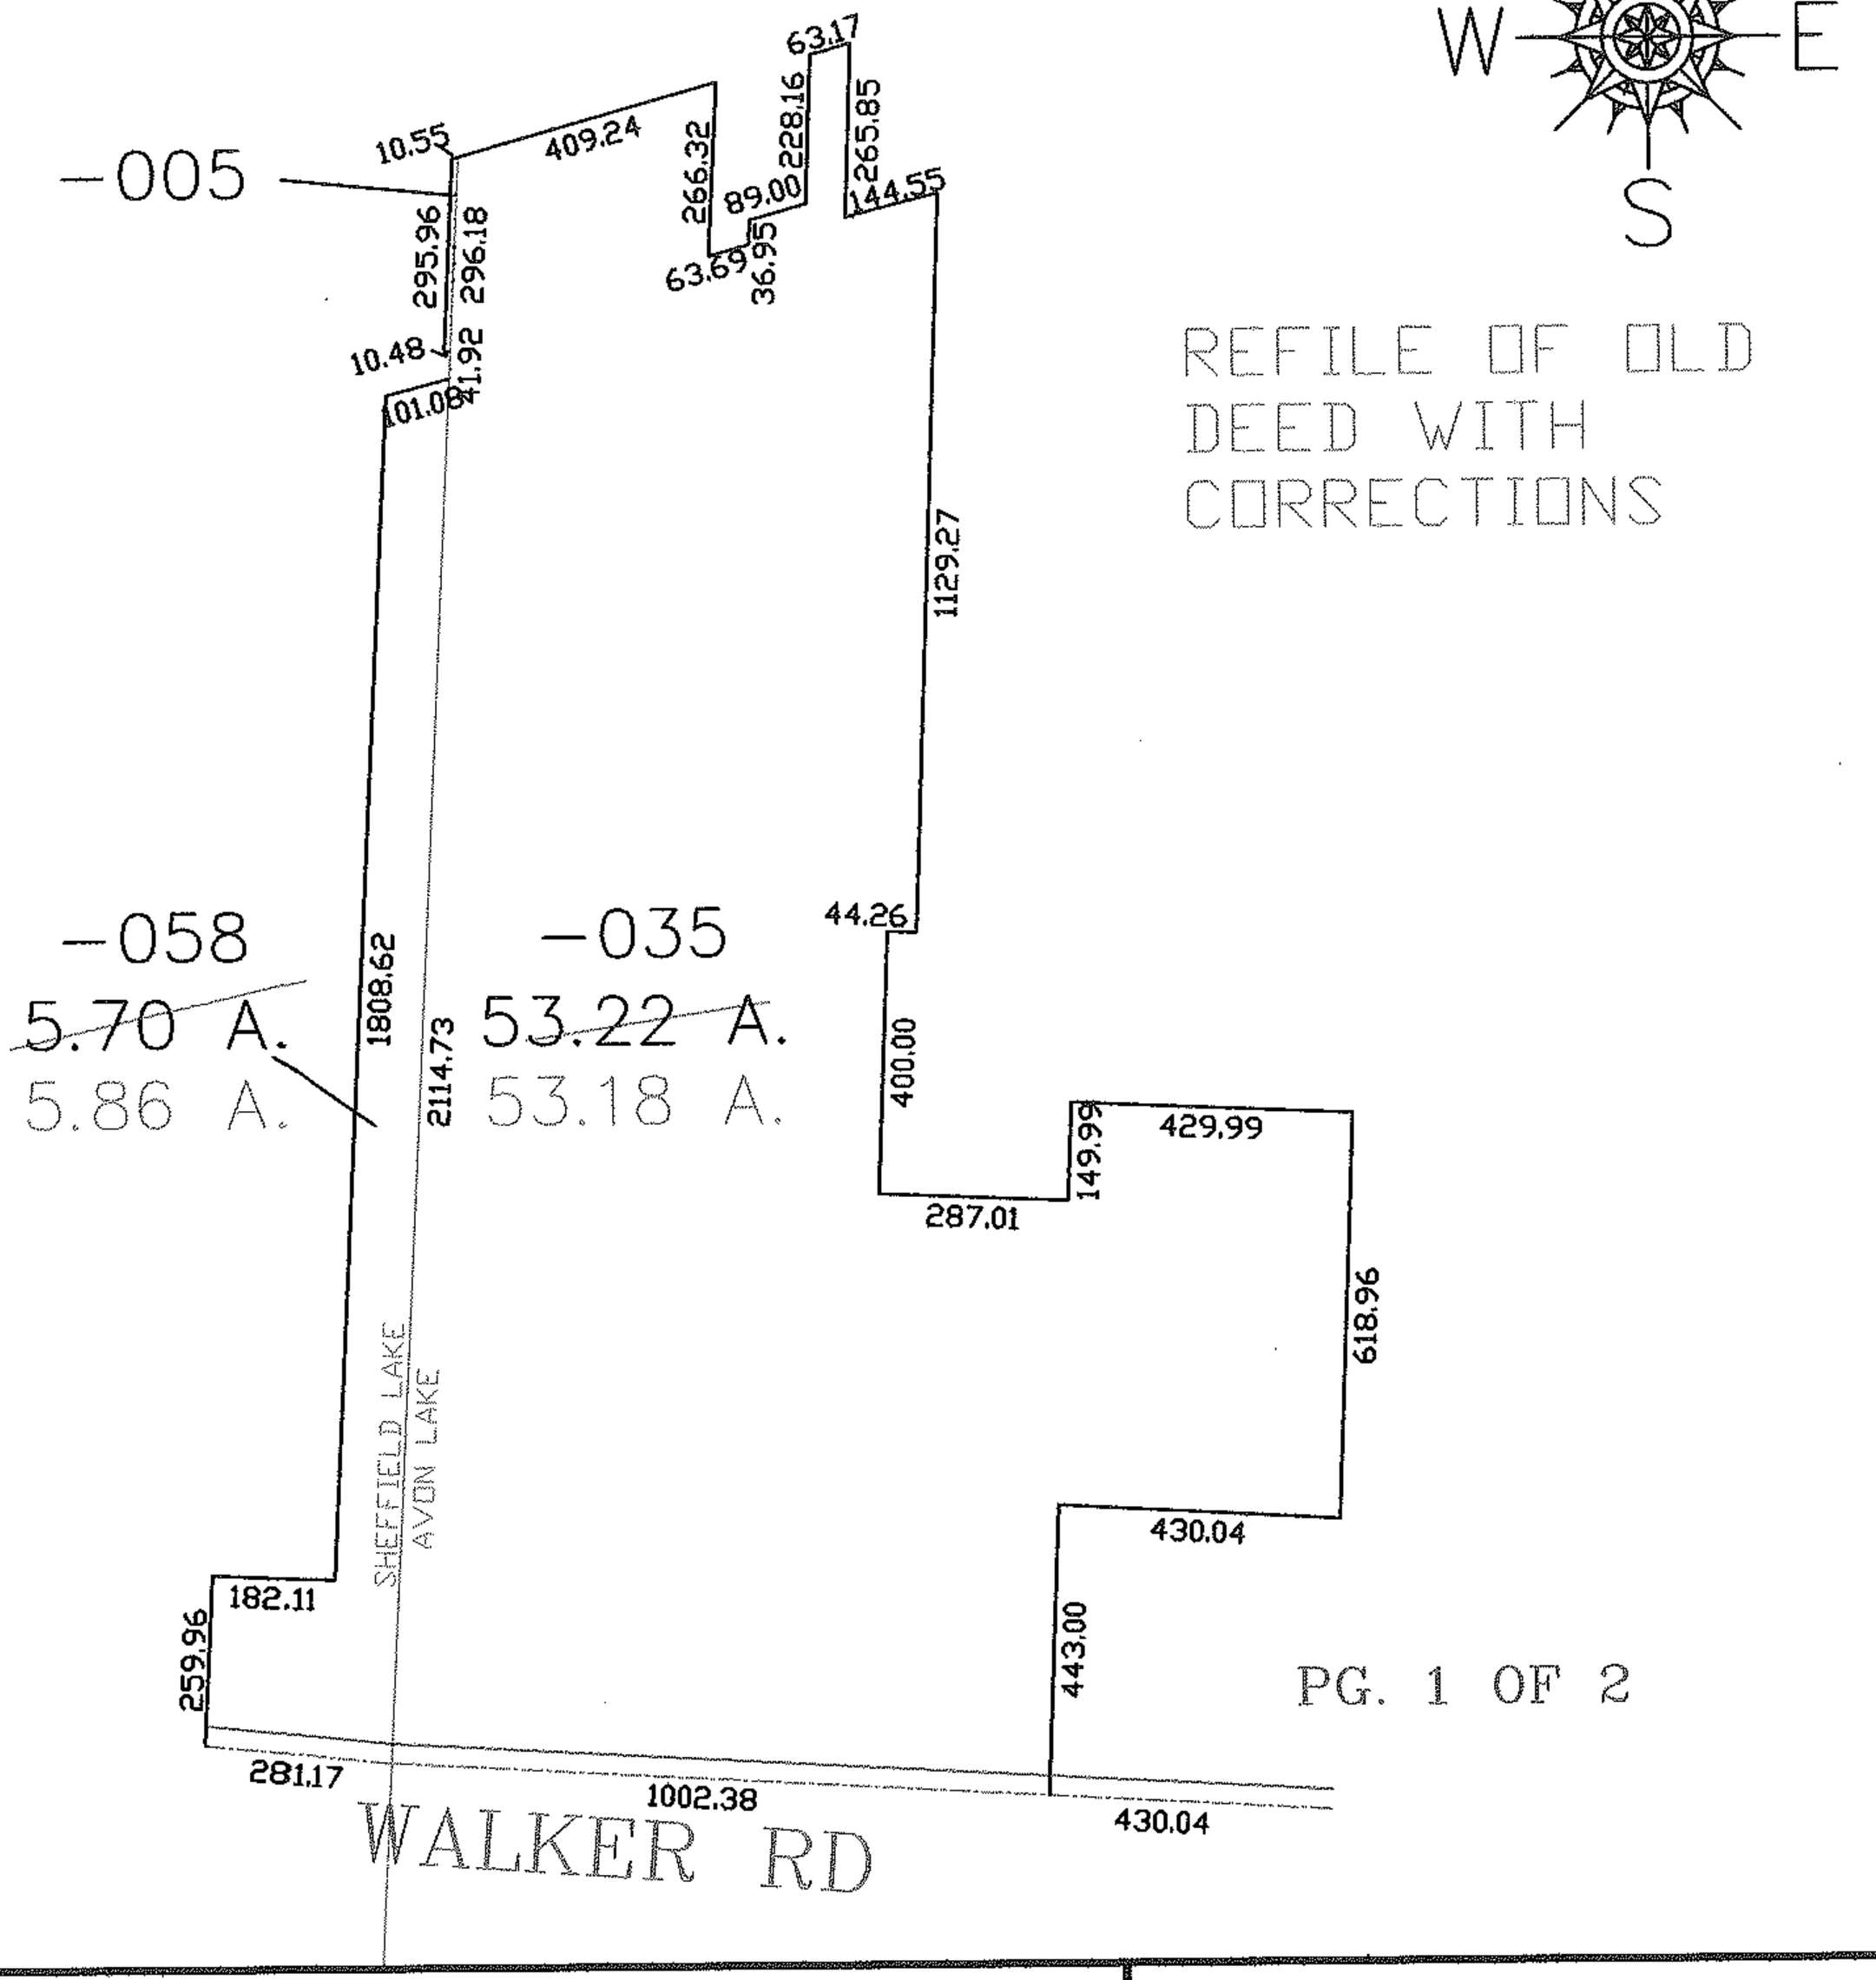

REFILE OF OLD DEED WITH CORRECTIONS

PG. 1 OF 2

SPLITS/DEEDS PROCESSED

LORAIN COUNTY TAX MAP DEPARTMENT
226 MIDDLE AVE. ELYRIA, OHIO

SURVEYED BY: DAVID L. ELWELL

CLOSURE: 1:10,000

MAP PAGE(S): 4-00-006-F

APPROVED BY: DRH DATE: 2/10/2005

SCALE: 1"= 400 PRIOR INSTRUMENT: 20040048389