RASTER

PARENT PARCEL: 16-00-045-000-028

CHILD PARCEL:

STARTING POINT: INTERSECTION OF C/L OF S.R.303 AND WESTERLY LINE OF O.L. 45

NO. 01109-C

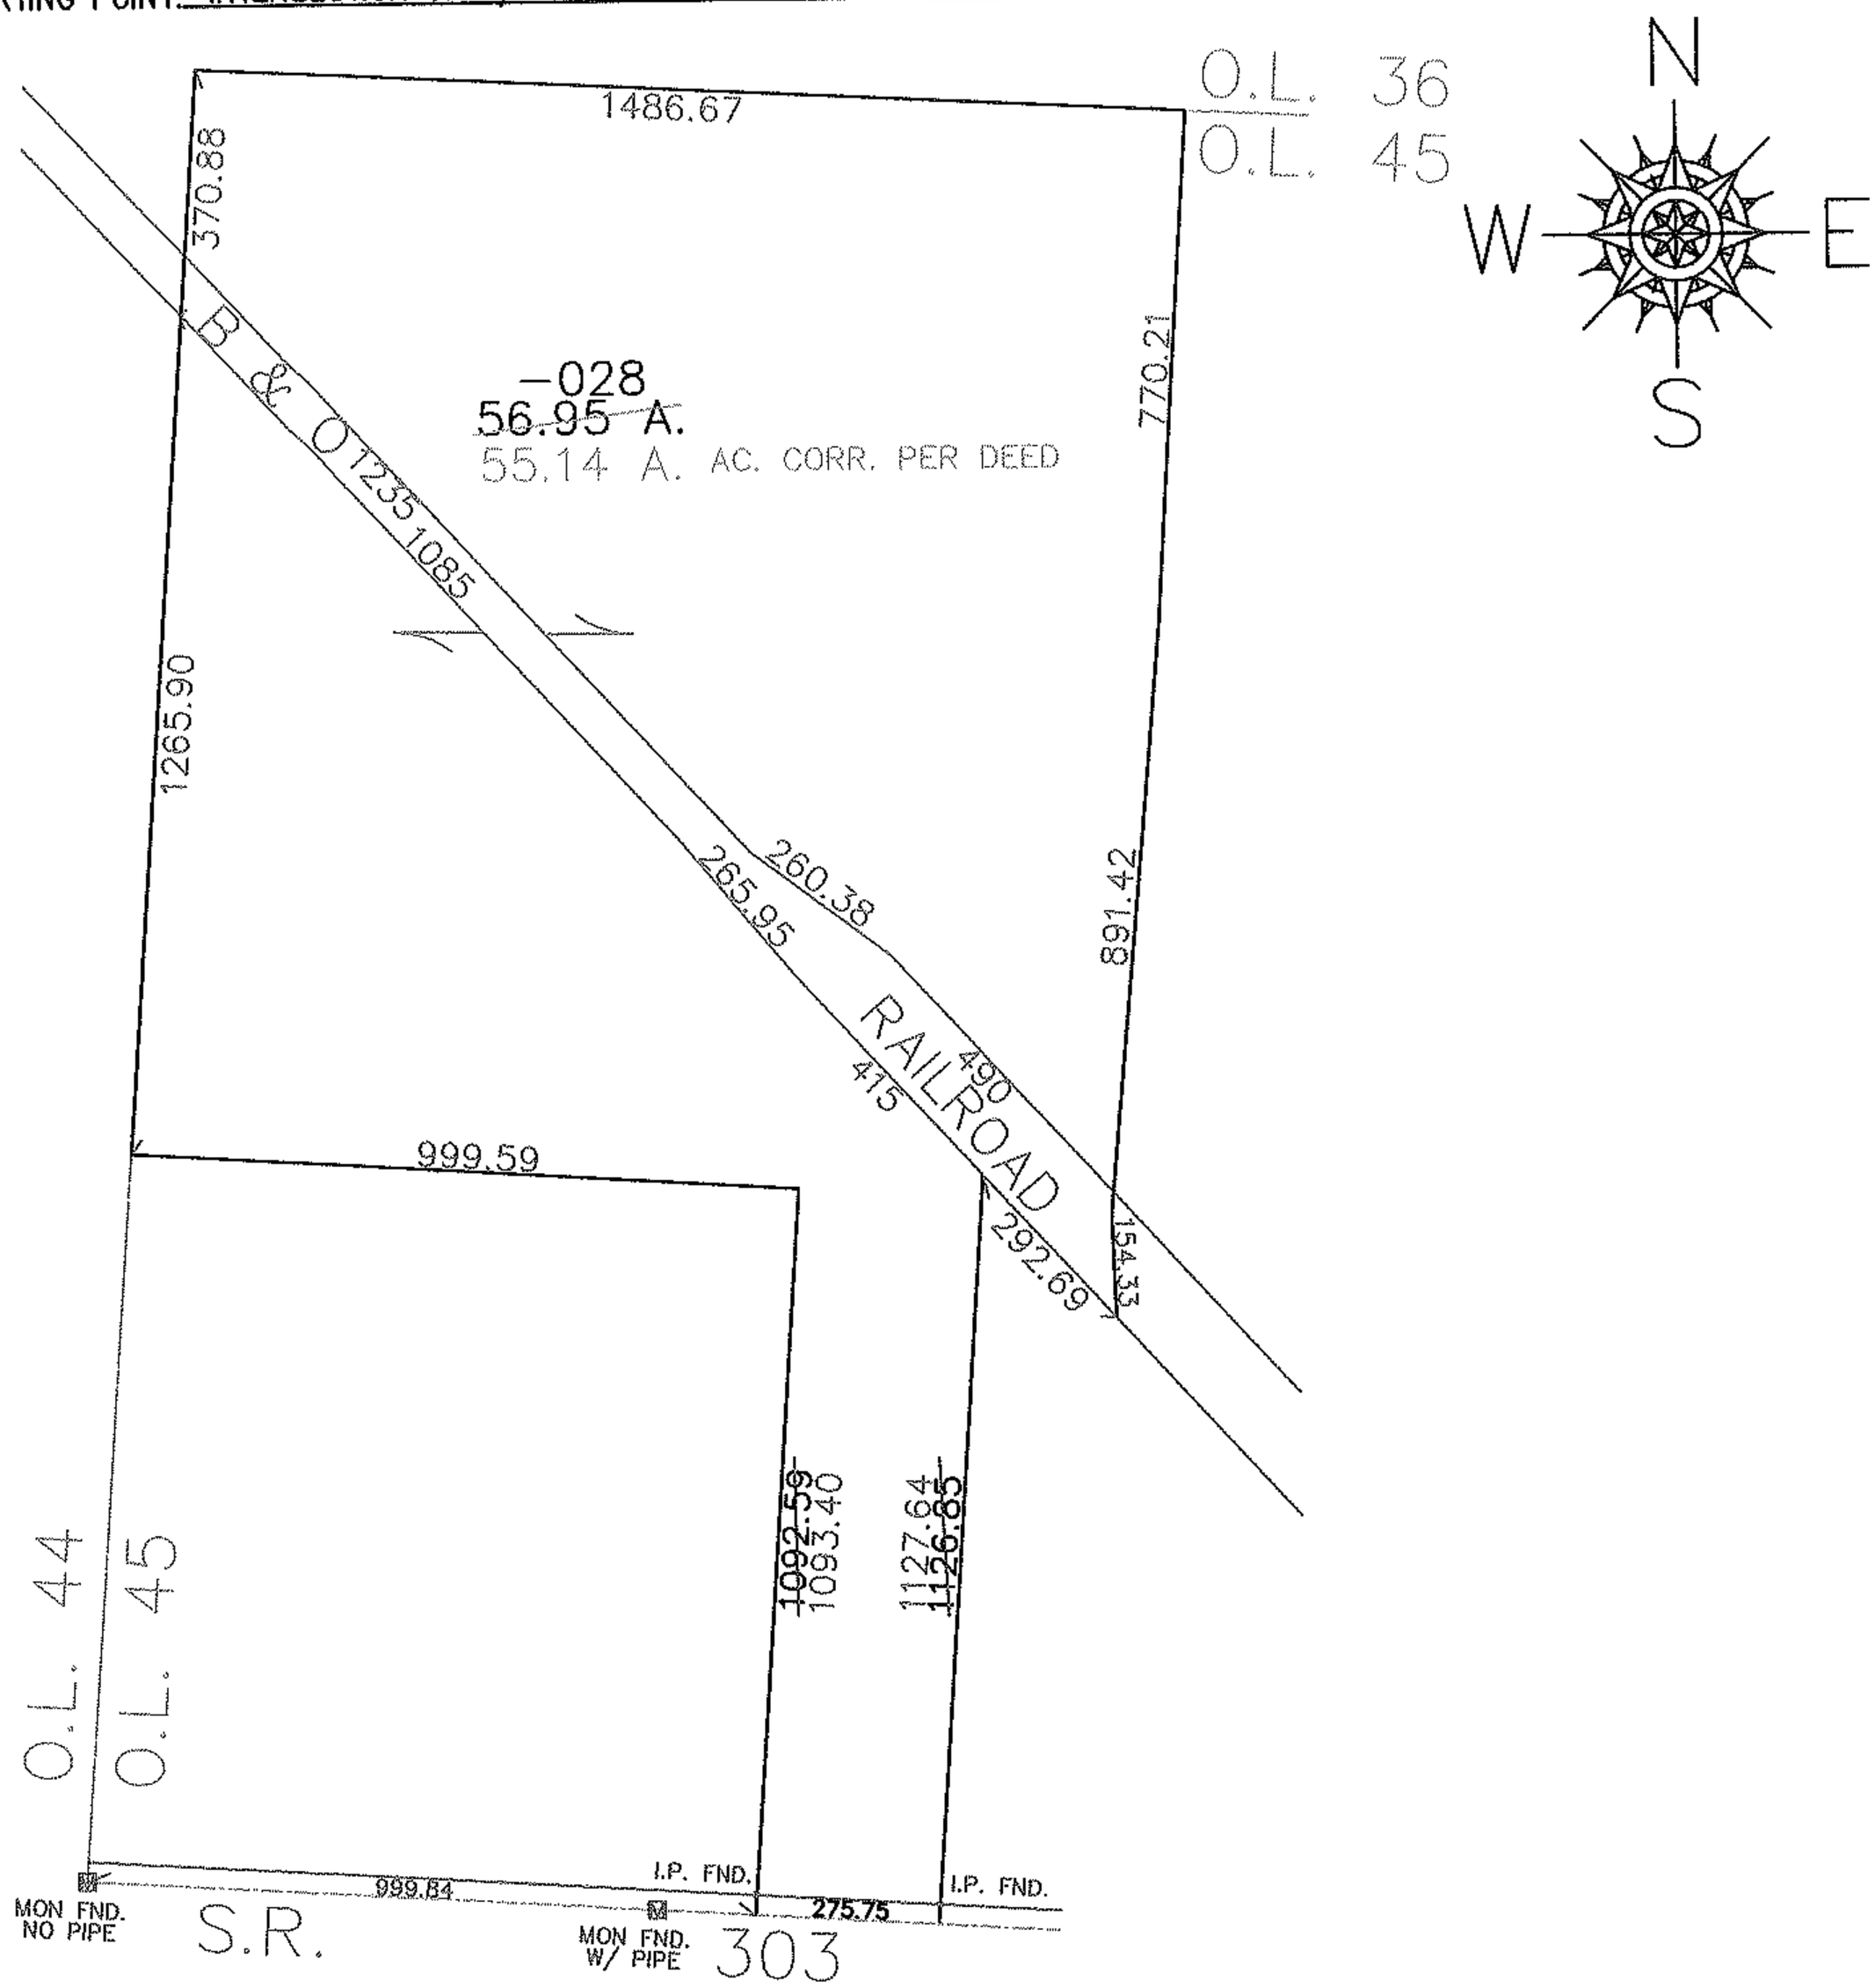

EXCEPTION WAS NOT SUBTRACTED

SPLITS/DEEDS PROCESSED

LORAIN COUNTY TAX MAP DEPARTMENT
226 MIDDLE AVE. ELYRIA, OHIO

SURVEYED BY: C.FLANIGAN

CLOSURE: N/A

MAP PAGE(S): 16-00-045-A & B

APPROVED BY: DRH DATE: 2/15/2005

SCALE: 1"= 400 PRIOR INSTRUMENT: 20010760839