RASTER

PARENT PARCEL: 10-00-005-107-064
CHILD PARCEL: --SAME--
STARTING POINT:

NO. 01131-C

N
W E
S

AC. CORR.
PER SURVEY
DALE HAYWOOD

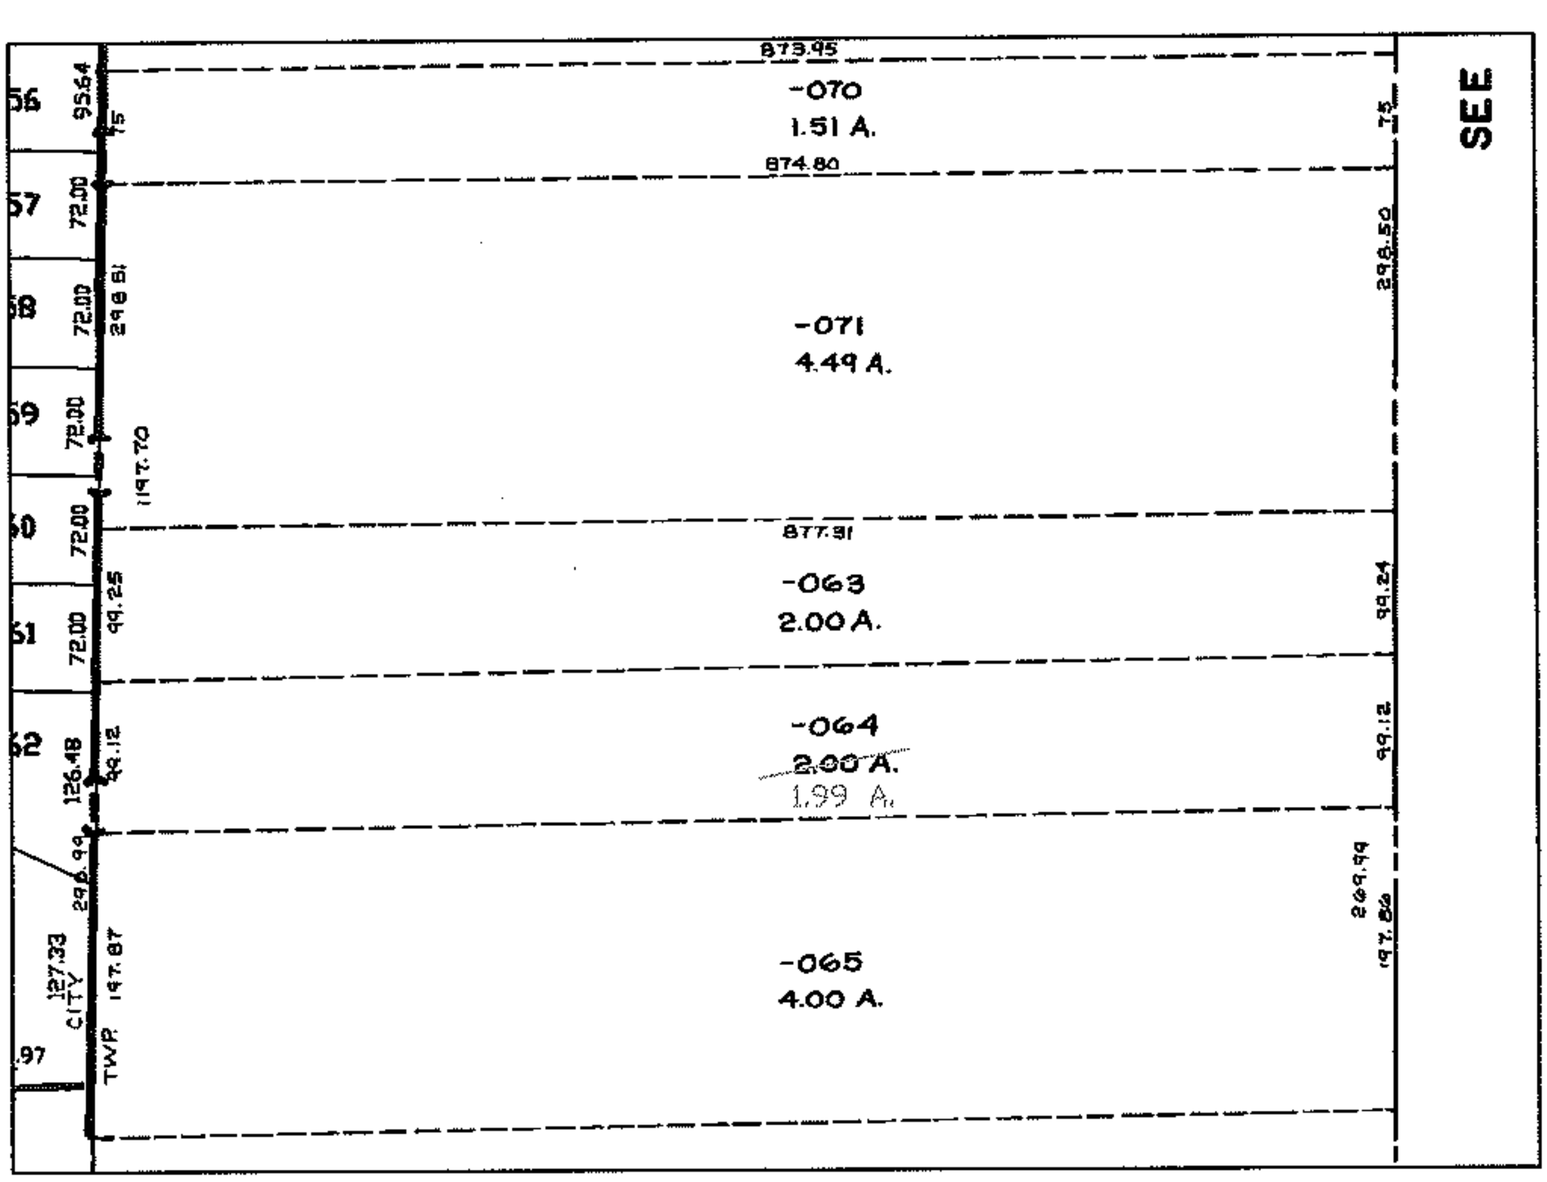

REMOVE
SURVEY BEFORE
NEXT TRANSFER

SPLITS/DEEDS PROCESSED
LORAIN COUNTY TAX MAP DEPARTMENT
226 MIDDLE AVE. ELYRIA, OHIO

SURVEYED BY: DALE HAYWOOD
CLOSURE: 1:10,000
MAP PAGE(S): 10-00-005-H
APPROVED BY: DRH DATE: 4/8/2005
SCALE: 1"= 300 PRIOR INSTRUMENT: