RASTER

PARENT PARCEL:

CHILD PARCEL:

STARTING POINT: NE CORNER OF SUB LOT 278

NO. 01136-C

N

W E

S

STREET VACATION
ORD # 2005-44

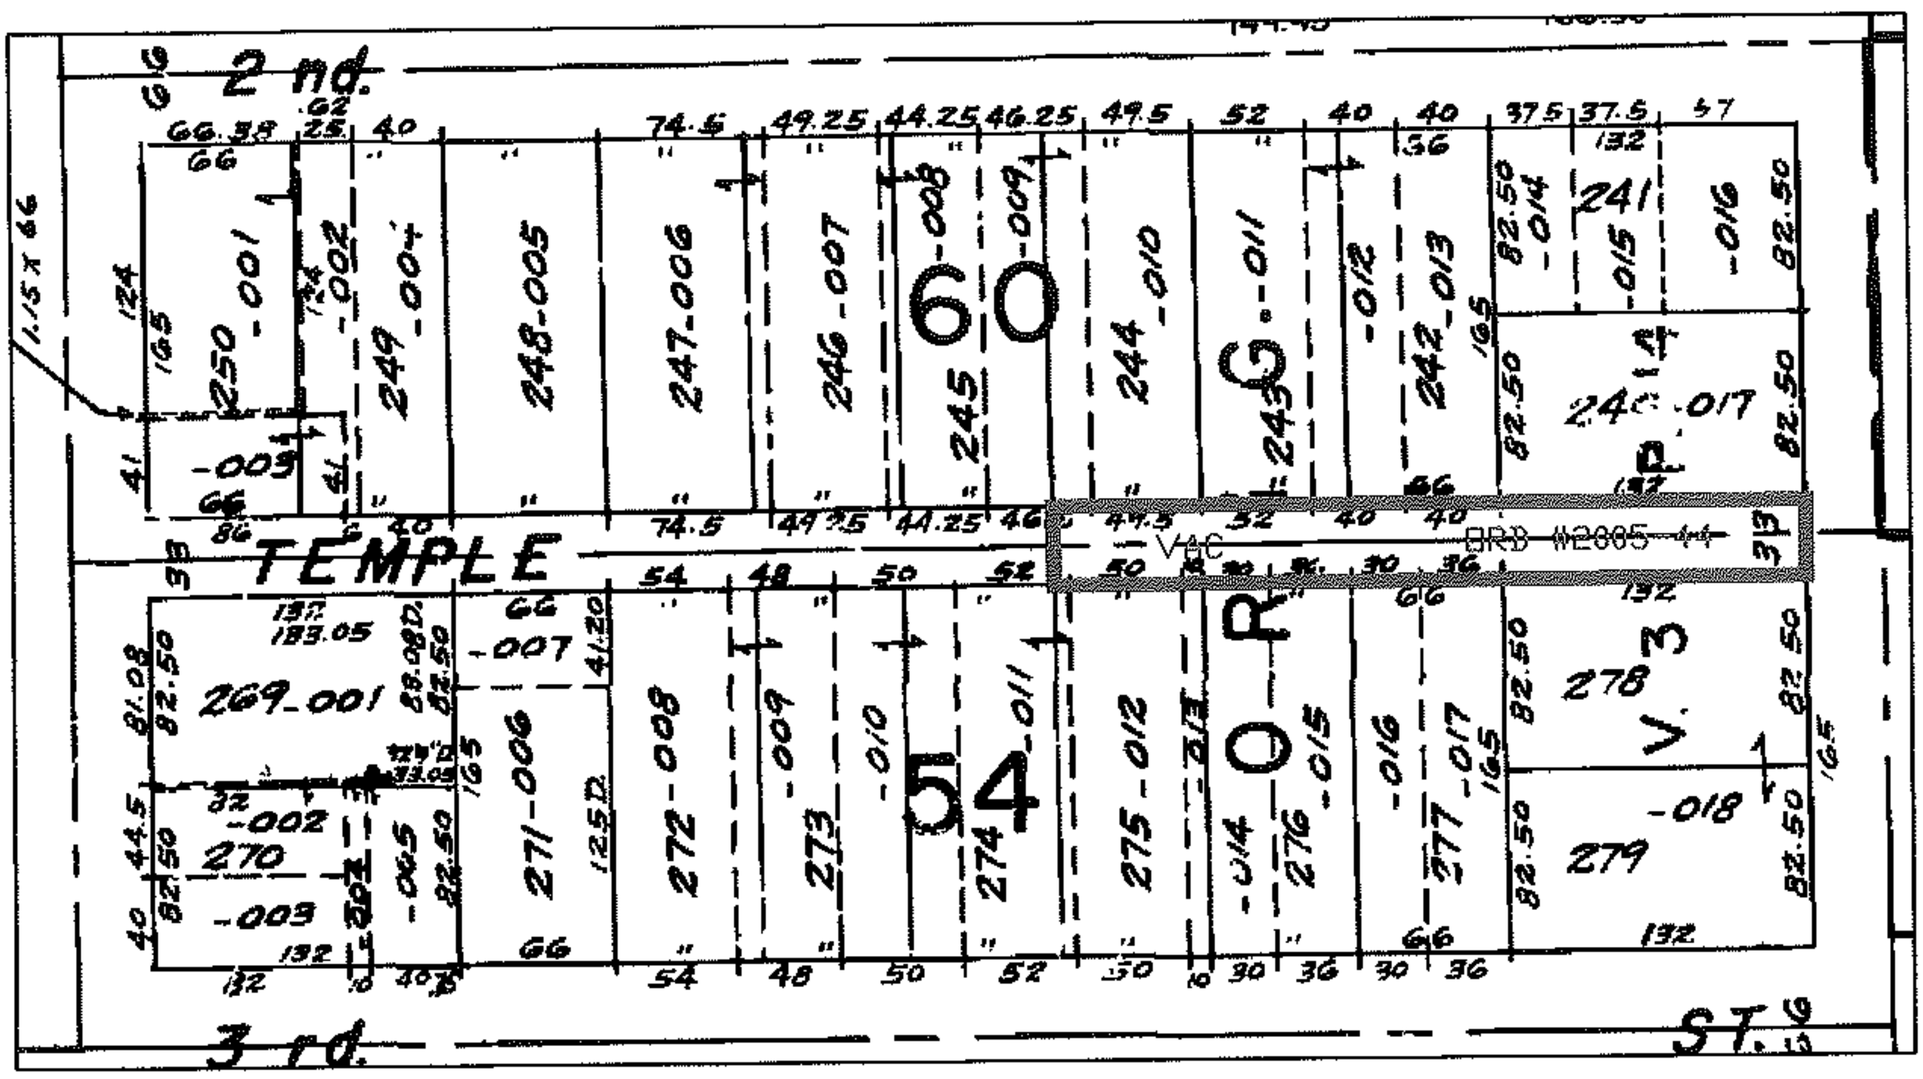

SPLITS/DEEDS PROCESSED

LORAIN COUNTY TAX MAP DEPARTMENT
226 MIDDLE AVE. ELYRIA, OHIO

SURVEYED BY: N/A

CLOSURE: N/A

MAP PAGE(S): 06-120

APPROVED BY: DRH DATE: 4/21/2005

SCALE: 1"= 200 PRIOR INSTRUMENT: