RASTER

PARENT PARCEL: 02-01-003-125-002
CHILD PARCEL: --SAME--
STARTING POINT:

NO. 01151-C

N
W E
S

DEPTH CORR
PER MAP AND DEED
NO MAP CORR

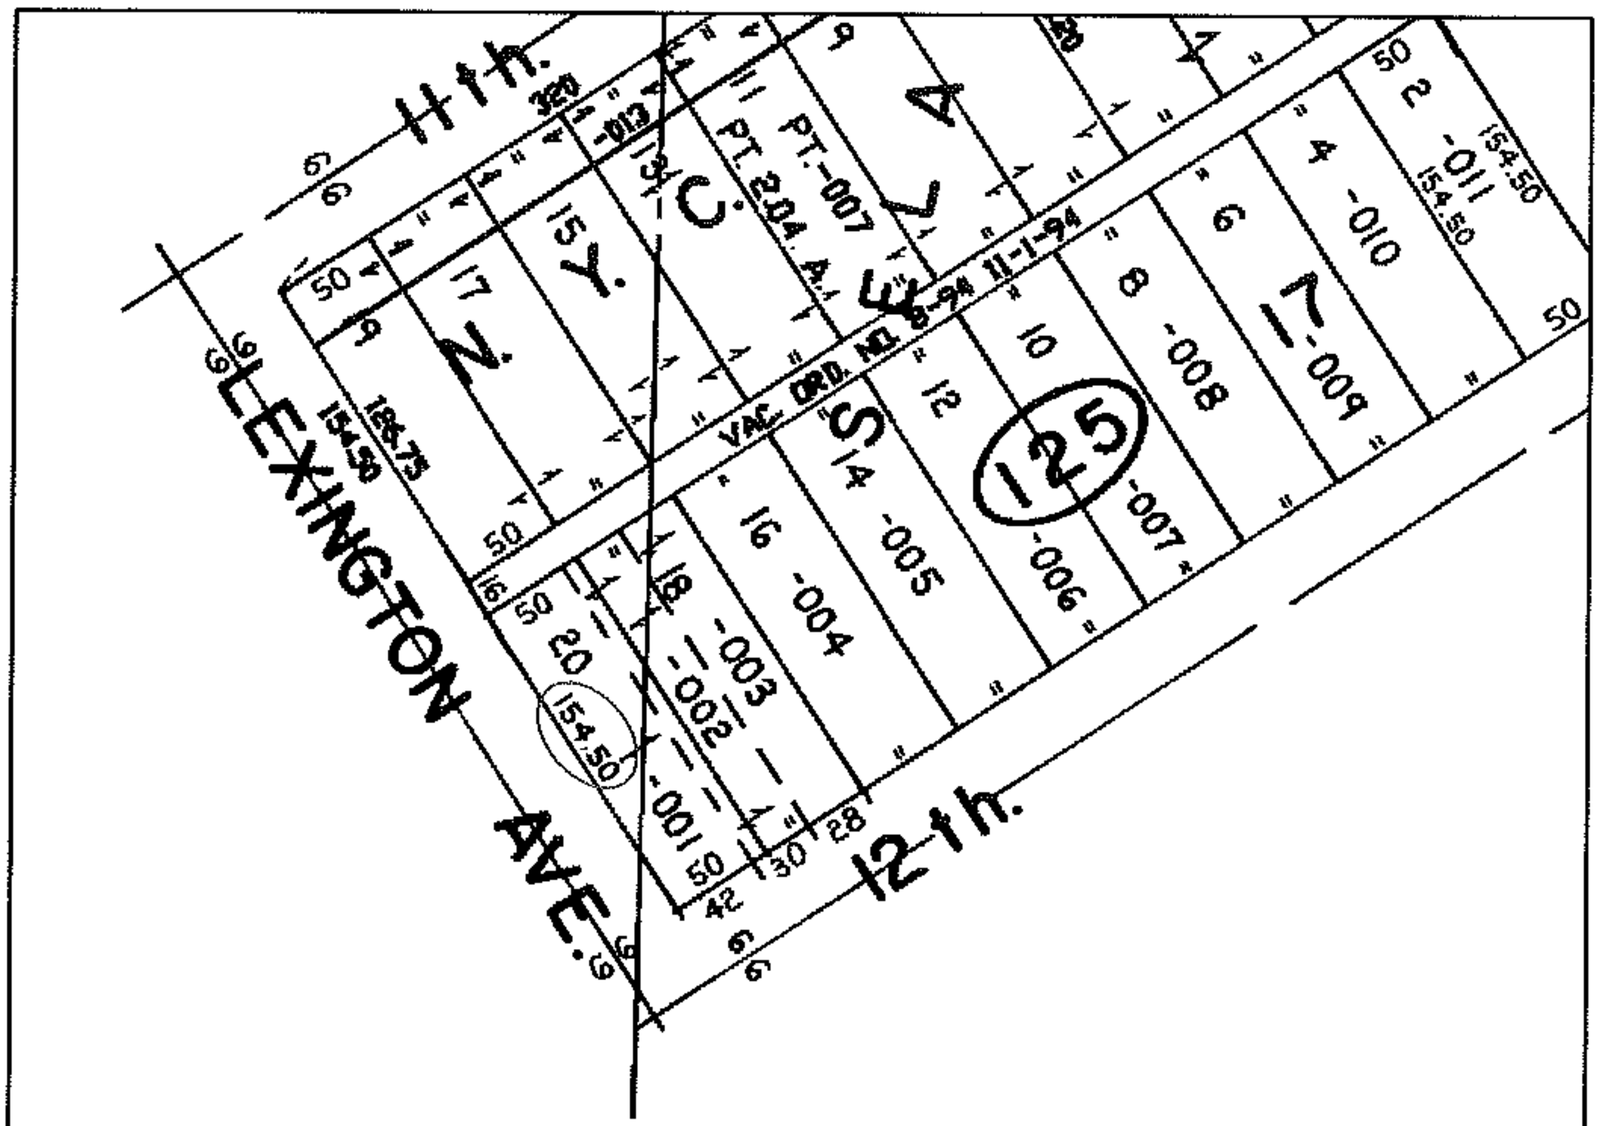

SPLITS/DEEDS PROCESSED
LORAIN COUNTY TAX MAP DEPARTMENT
226 MIDDLE AVE. ELYRIA, OHIO

SURVEYED BY: N/A
CLOSURE: N/A
MAP PAGE(S): 02-01-003-C
APPROVED BY: DRH DATE: 5/16/2005
SCALE: 1"= 200 PRIOR INSTRUMENT: DV 588/14