RASTER

PARENT PARCEL: 08-00-102-000-003

CHILD PARCEL: --SAME--

STARTING POINT:

NO. 1155-C

AC. CORR.

PER DEED

N

W E

S

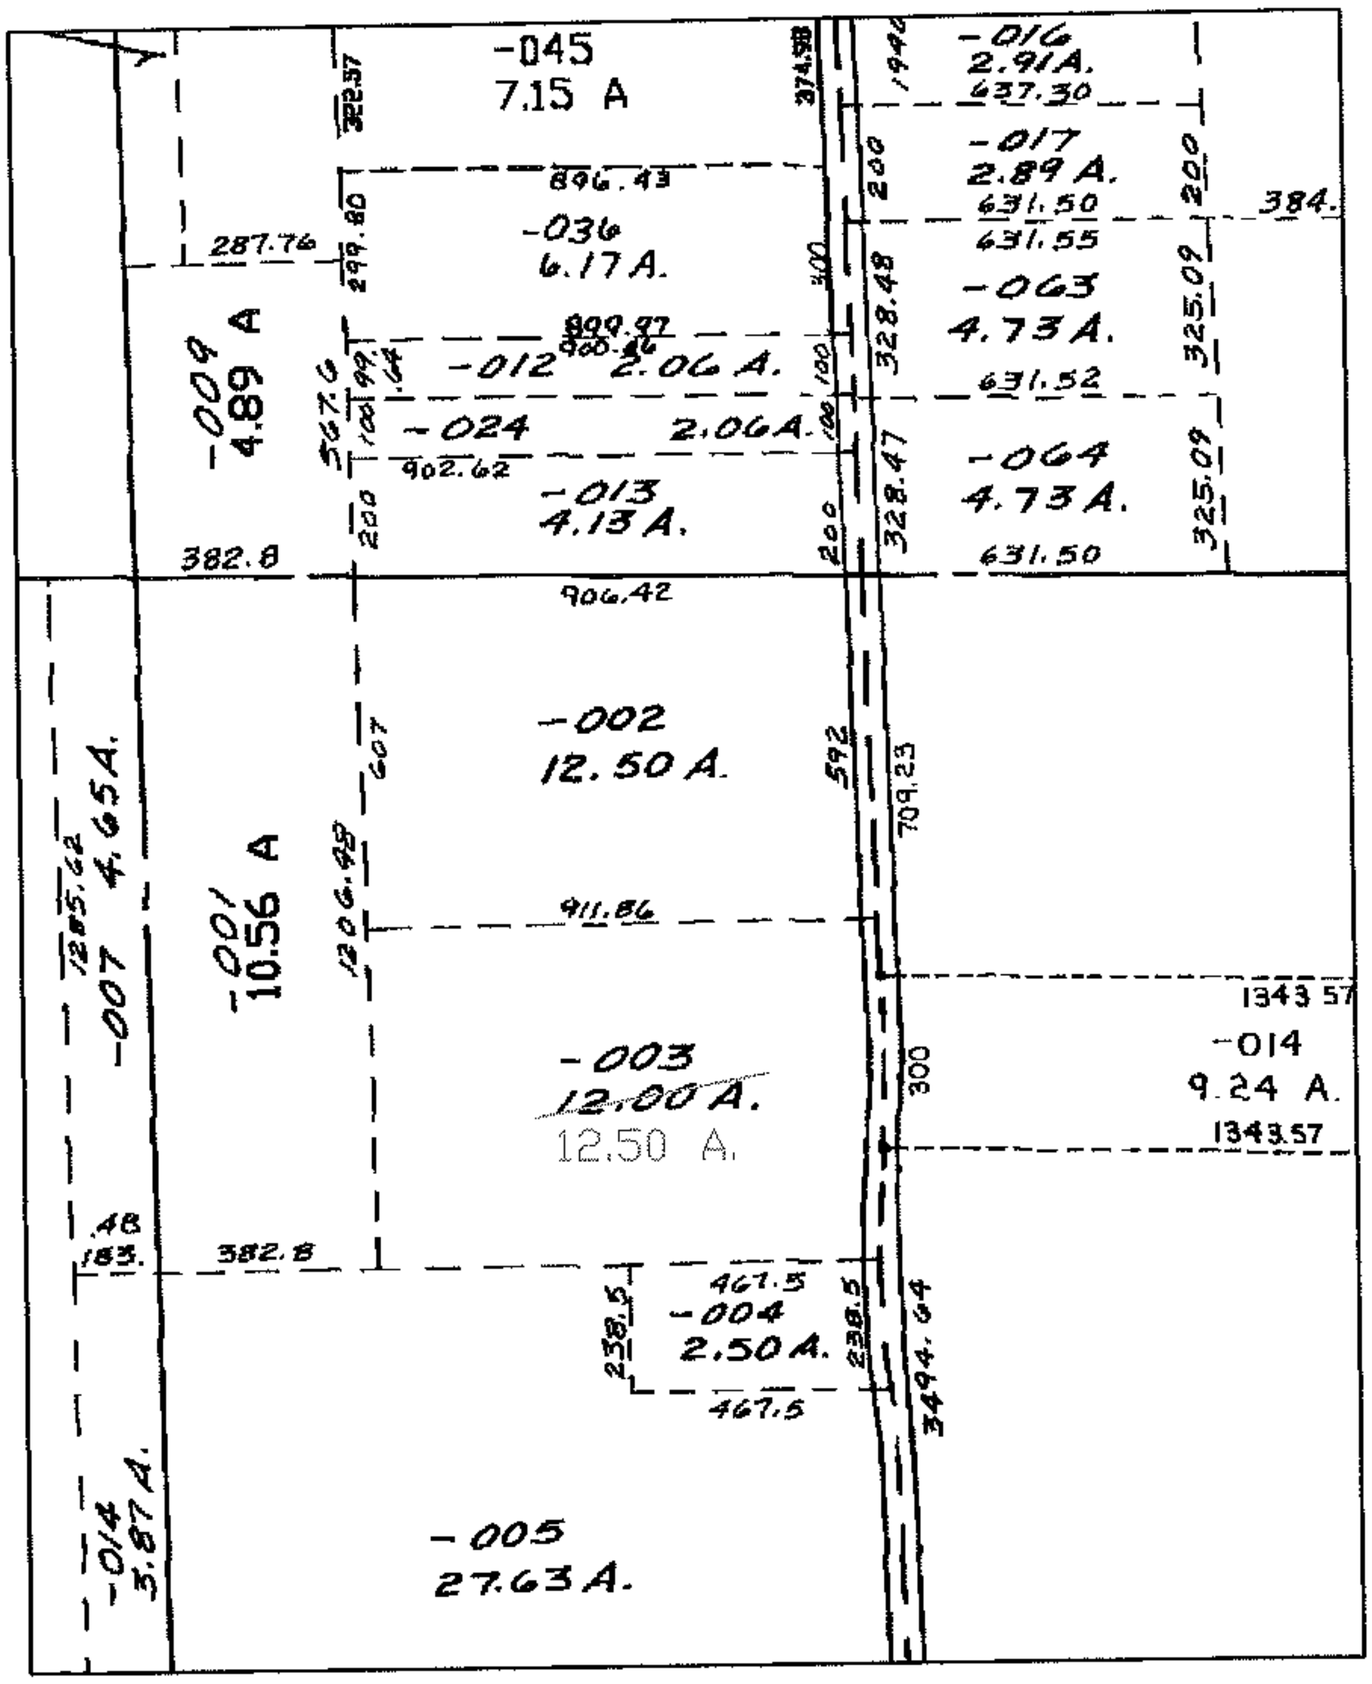

SPLITS/DEEDS PROCESSED

LORAIN COUNTY TAX MAP DEPARTMENT
226 MIDDLE AVE. ELYRIA, OHIO

SURVEYED BY: N/A

CLOSURE: N/A

MAP PAGE(S): 8-C

APPROVED BY: DRH DATE: 5/26/2005

SCALE: 1"= 200 PRIOR INSTRUMENT: 1397/296