RASTER

PARENT PARCEL: 02-01-006-145-005
CHILD PARCEL: --SAME--
STARTING POINT:

NO. 01156-C

DEPTH CORR
PER DEED AND MAP

N
W E
S

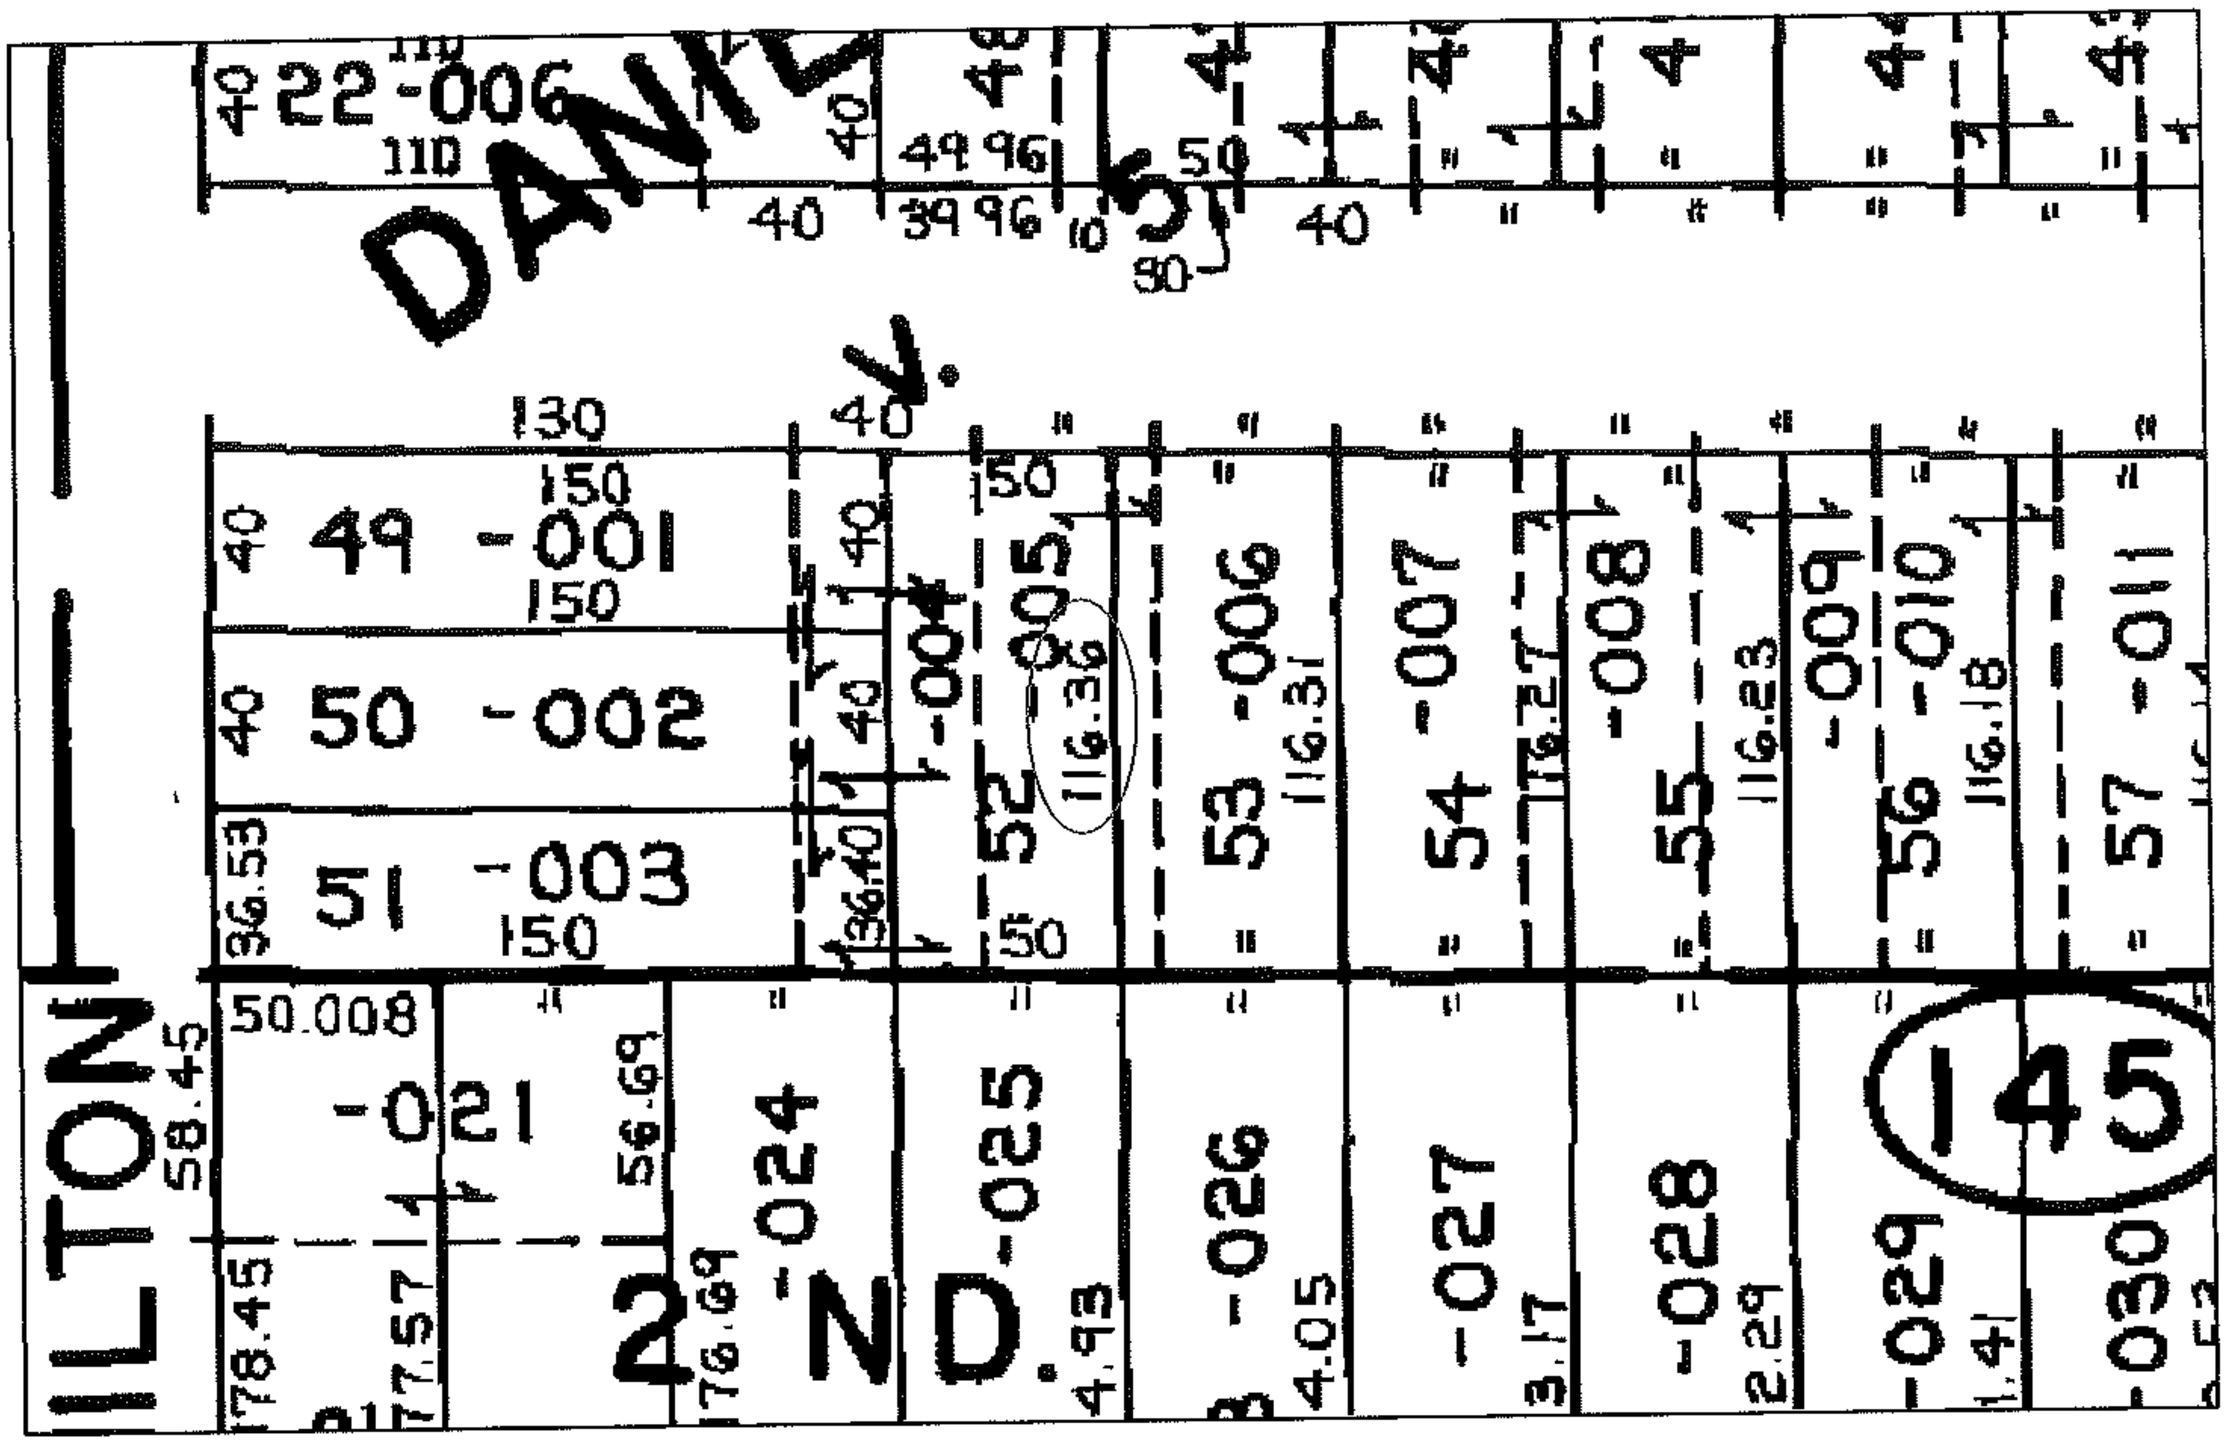

SPLITS/DEEDS PROCESSED

LORAIN COUNTY TAX MAP DEPARTMENT
226 MIDDLE AVE. ELYRIA, OHIO

SURVEYED BY:
CLOSURE:
MAP PAGE(S): 02-01-006-C
APPROVED BY: DRH DATE: 5/27/2005
SCALE: 1"= 100 PRIOR INSTRUMENT: