RASTER

PARENT PARCEL: 06-25-162-101-054
CHILD PARCEL: 06-25-162-101-058 & -059
STARTING POINT:

NO. 01170-U

UNCOMBINATION PER DEED

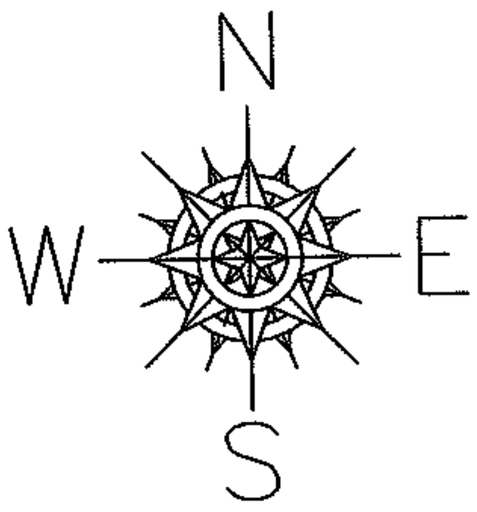

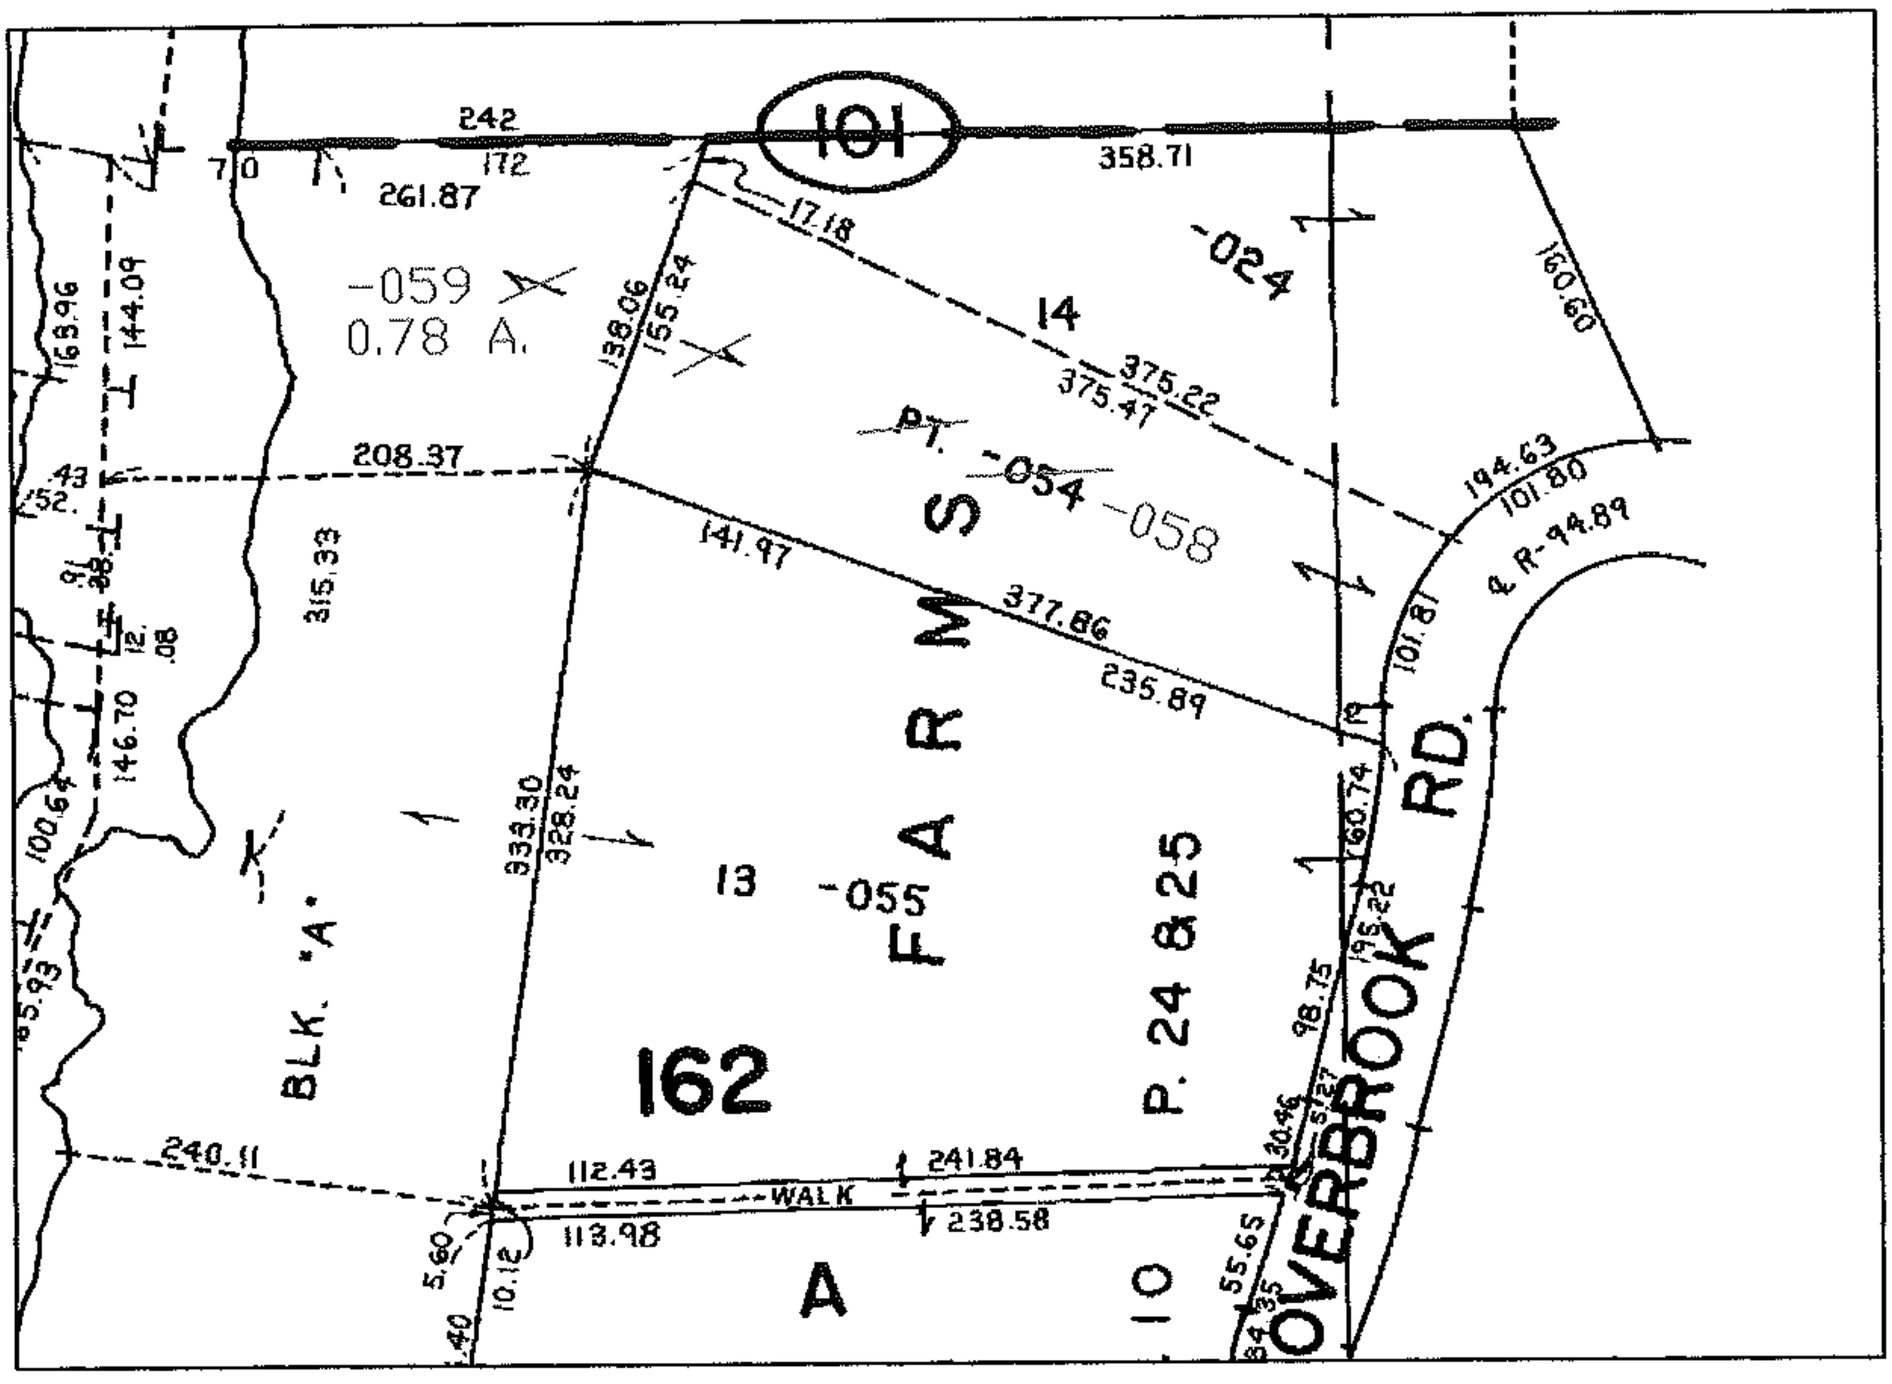

PRIOR INSTRUMENT: OR 2 635
PRIOR INSTRUMENT: DV 885/139

SPLITS/DEEDS PROCESSED

LORAIN COUNTY TAX MAP DEPARTMENT
226 MIDDLE AVE. ELYRIA, OHIO

SURVEYED BY: N/A
CLOSURE: N/A
MAP PAGE(S): 06-66
APPROVED BY: DRH DATE: 7/11/2005
SCALE: 1"= 200