RASTER

PARENT PARCEL: 02-01-004-101-043

CHILD PARCEL: --SAME--

STARTING POINT:

NO. 01177-C

DEPTH CORR
PER DEED/MAP
DUPLICATE CORR
ONLY - No MAP Corr

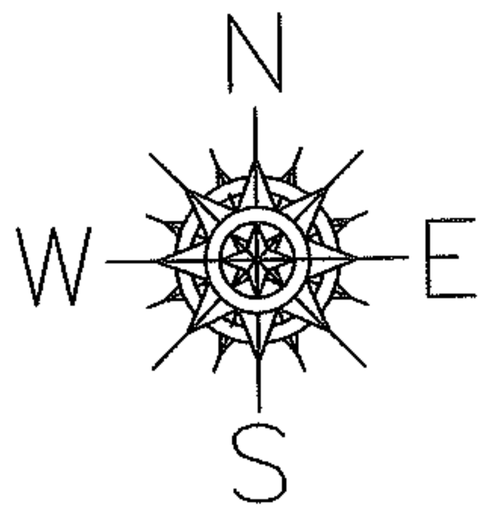

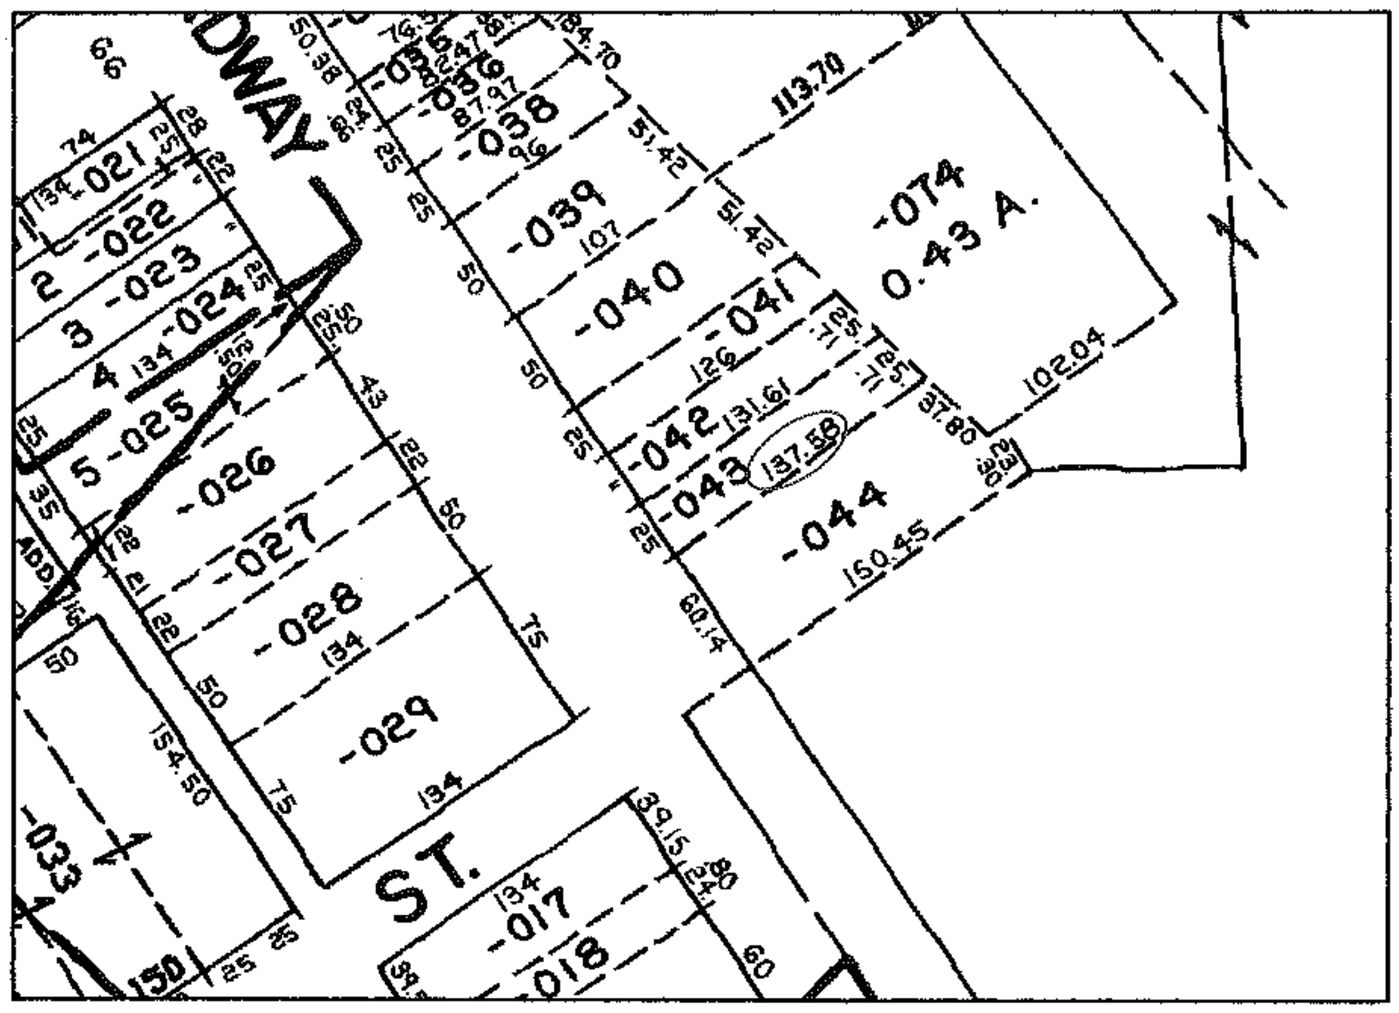

SPLITS/DEEDS PROCESSED

LORAIN COUNTY TAX MAP DEPARTMENT
226 MIDDLE AVE. ELYRIA, OHIO

SURVEYED BY: N/A

CLOSURE: N/A

MAP PAGE(S): 02-01-004-B

APPROVED BY: DRH DATE: 7/20/2005

SCALE: 1"= 200 PRIOR INSTRUMENT: 200507130