RASTER

PARENT PARCEL: 09-00-086-105-001
CHILD PARCEL: --SAME--
STARTING POINT: INT CL LORAIN ST AND CL N PLEASANT ST

NO. 01178-C

CORR PER DEED AND PLAT

N
W E
S

9-00-076-A

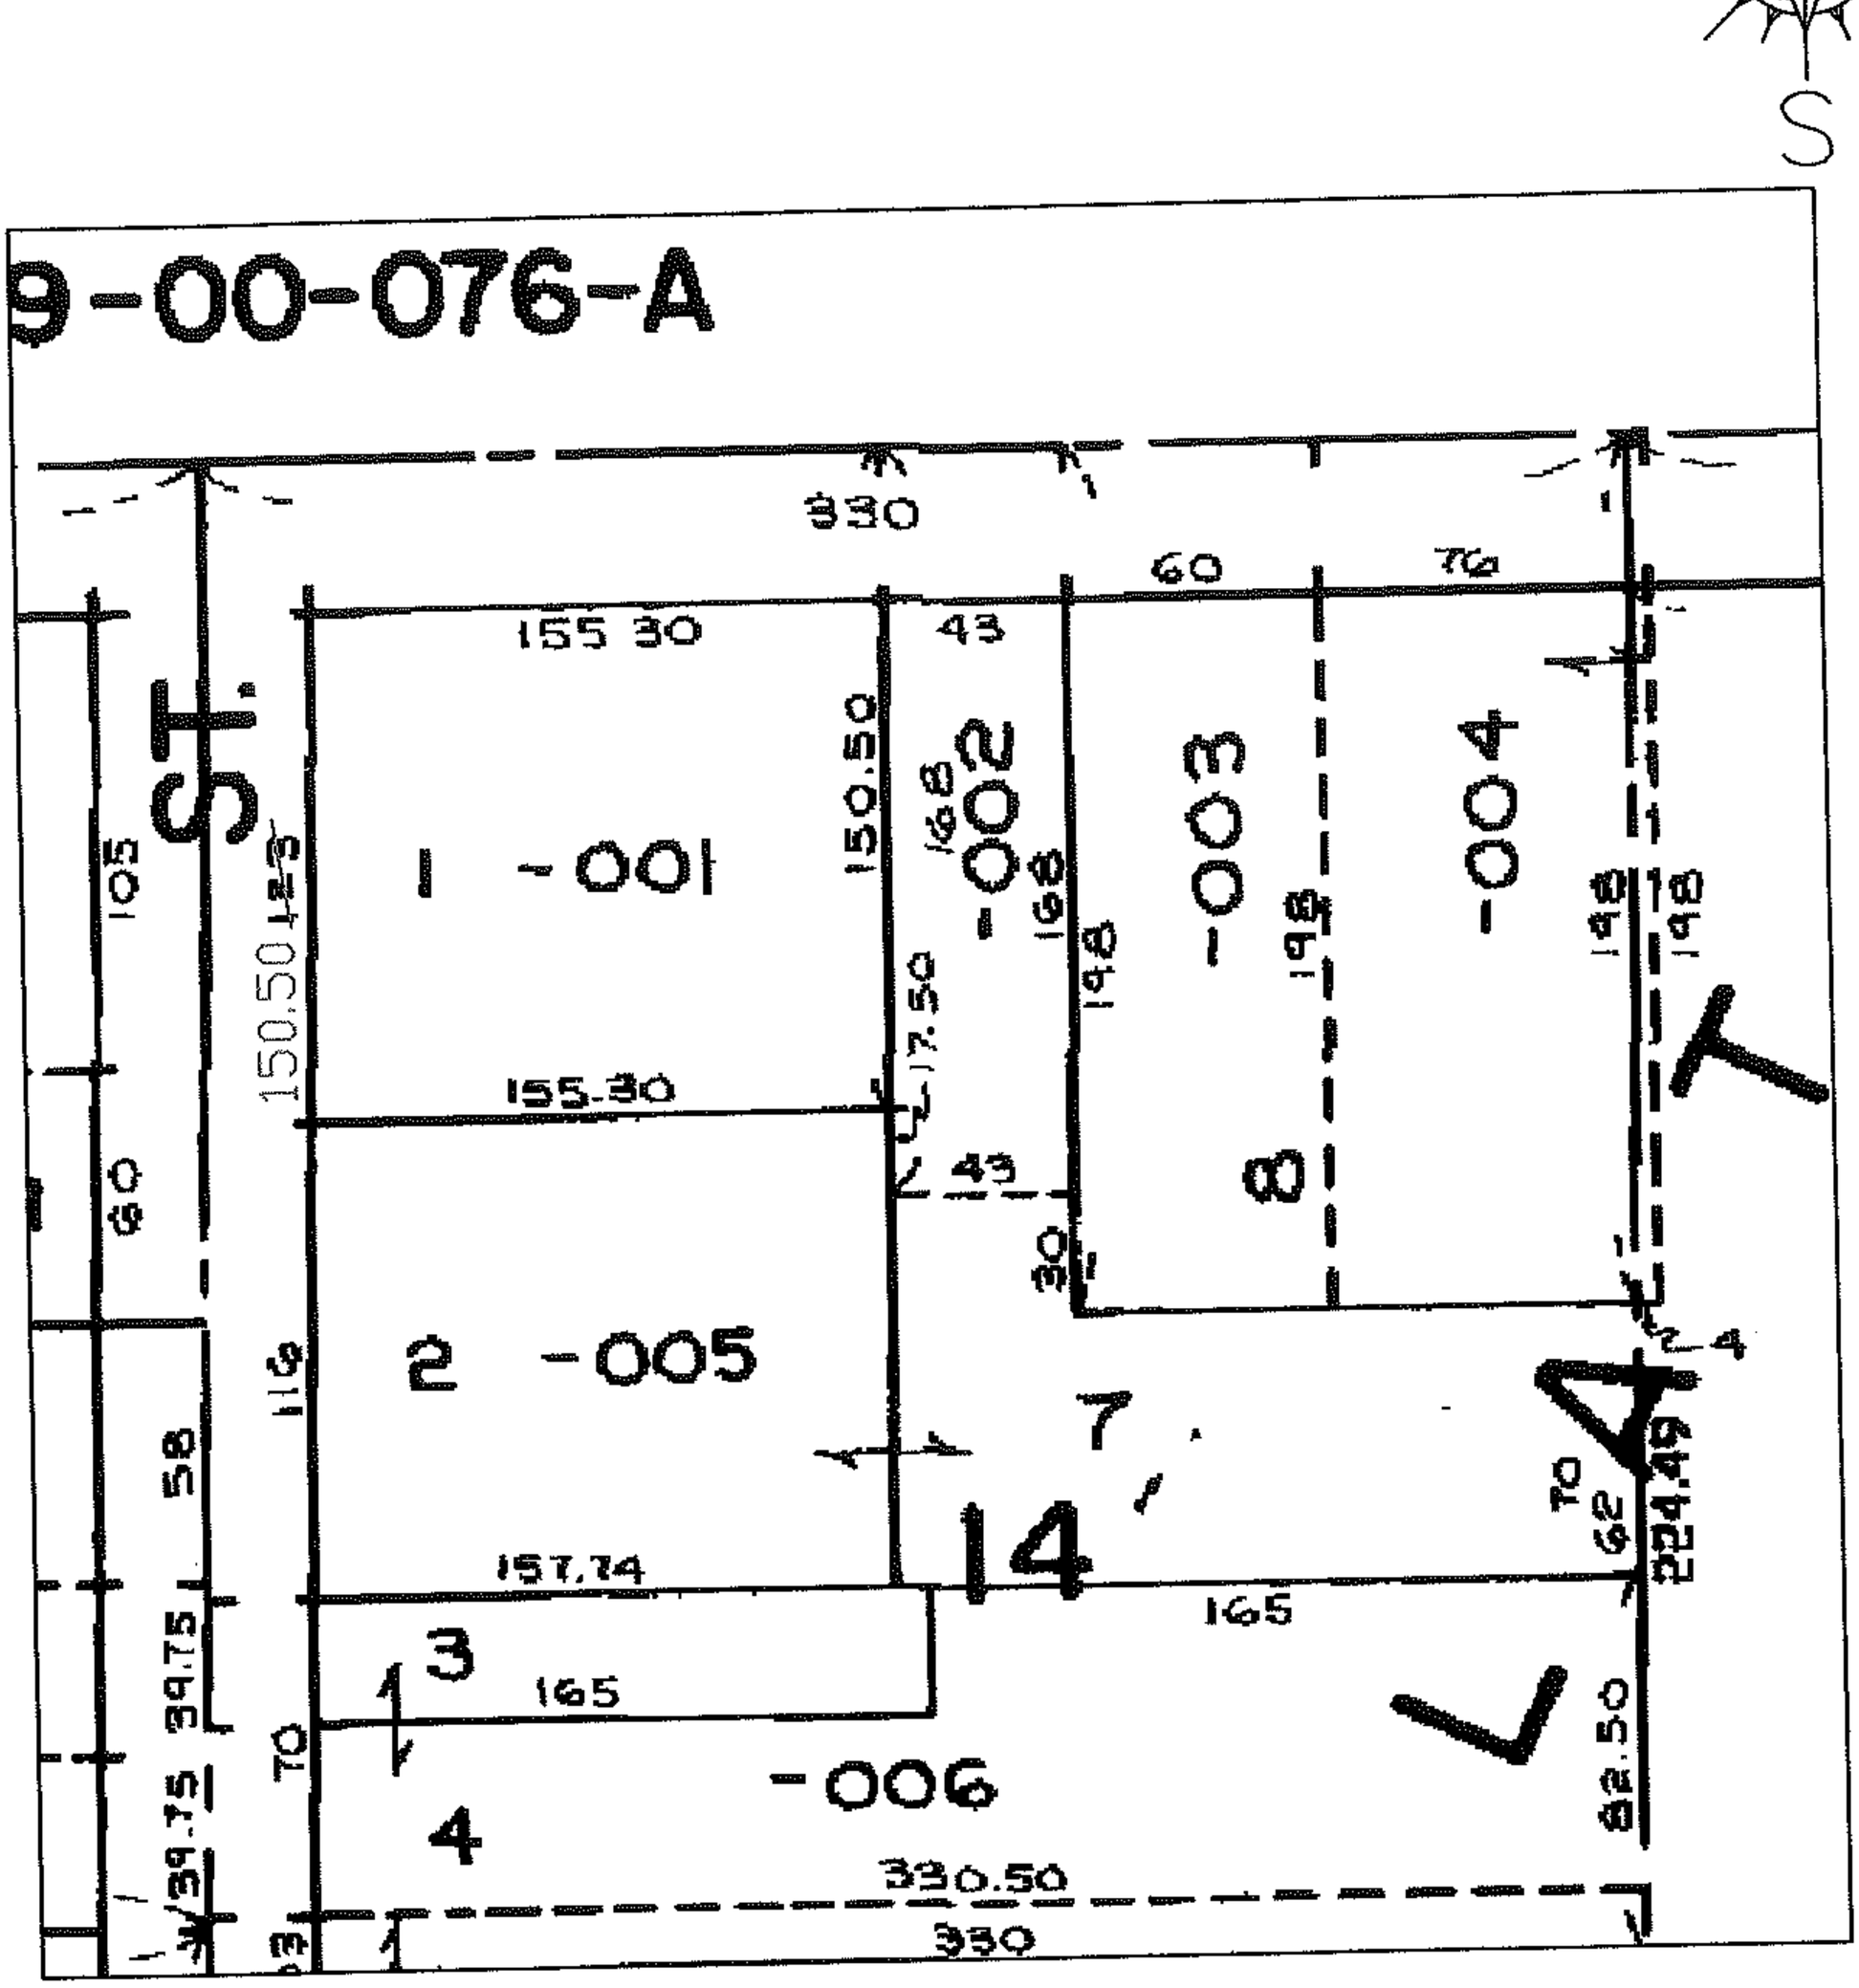

SPLITS/DEEDS PROCESSED

LORAIN COUNTY TAX MAP DEPARTMENT
226 MIDDLE AVE. ELYRIA, OHIO

SURVEYED BY: N/A
CLOSURE: N/A
MAP PAGE(S): 09-00-086-A
APPROVED BY: DRH DATE: 8/1/2005
SCALE: 1"= 100 PRIOR INSTRUMENT: 20040031084