RASTER

PARENT PARCEL: 09-00-075-107-003
CHILD PARCEL: --SAME--
STARTING POINT:

NO. 01189-C

AC. CORR.
PER DEED
REMOVE UPDATE LEGAL

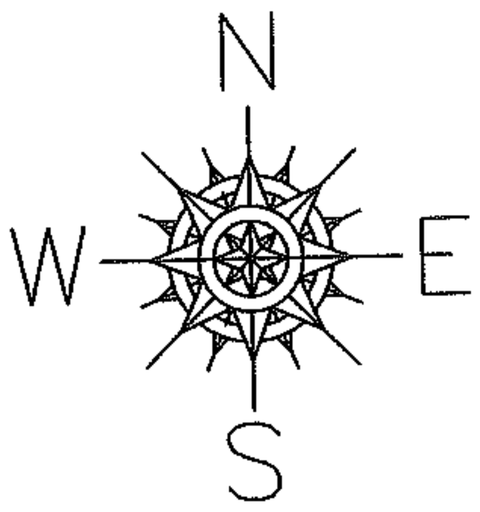

9-00-065-B

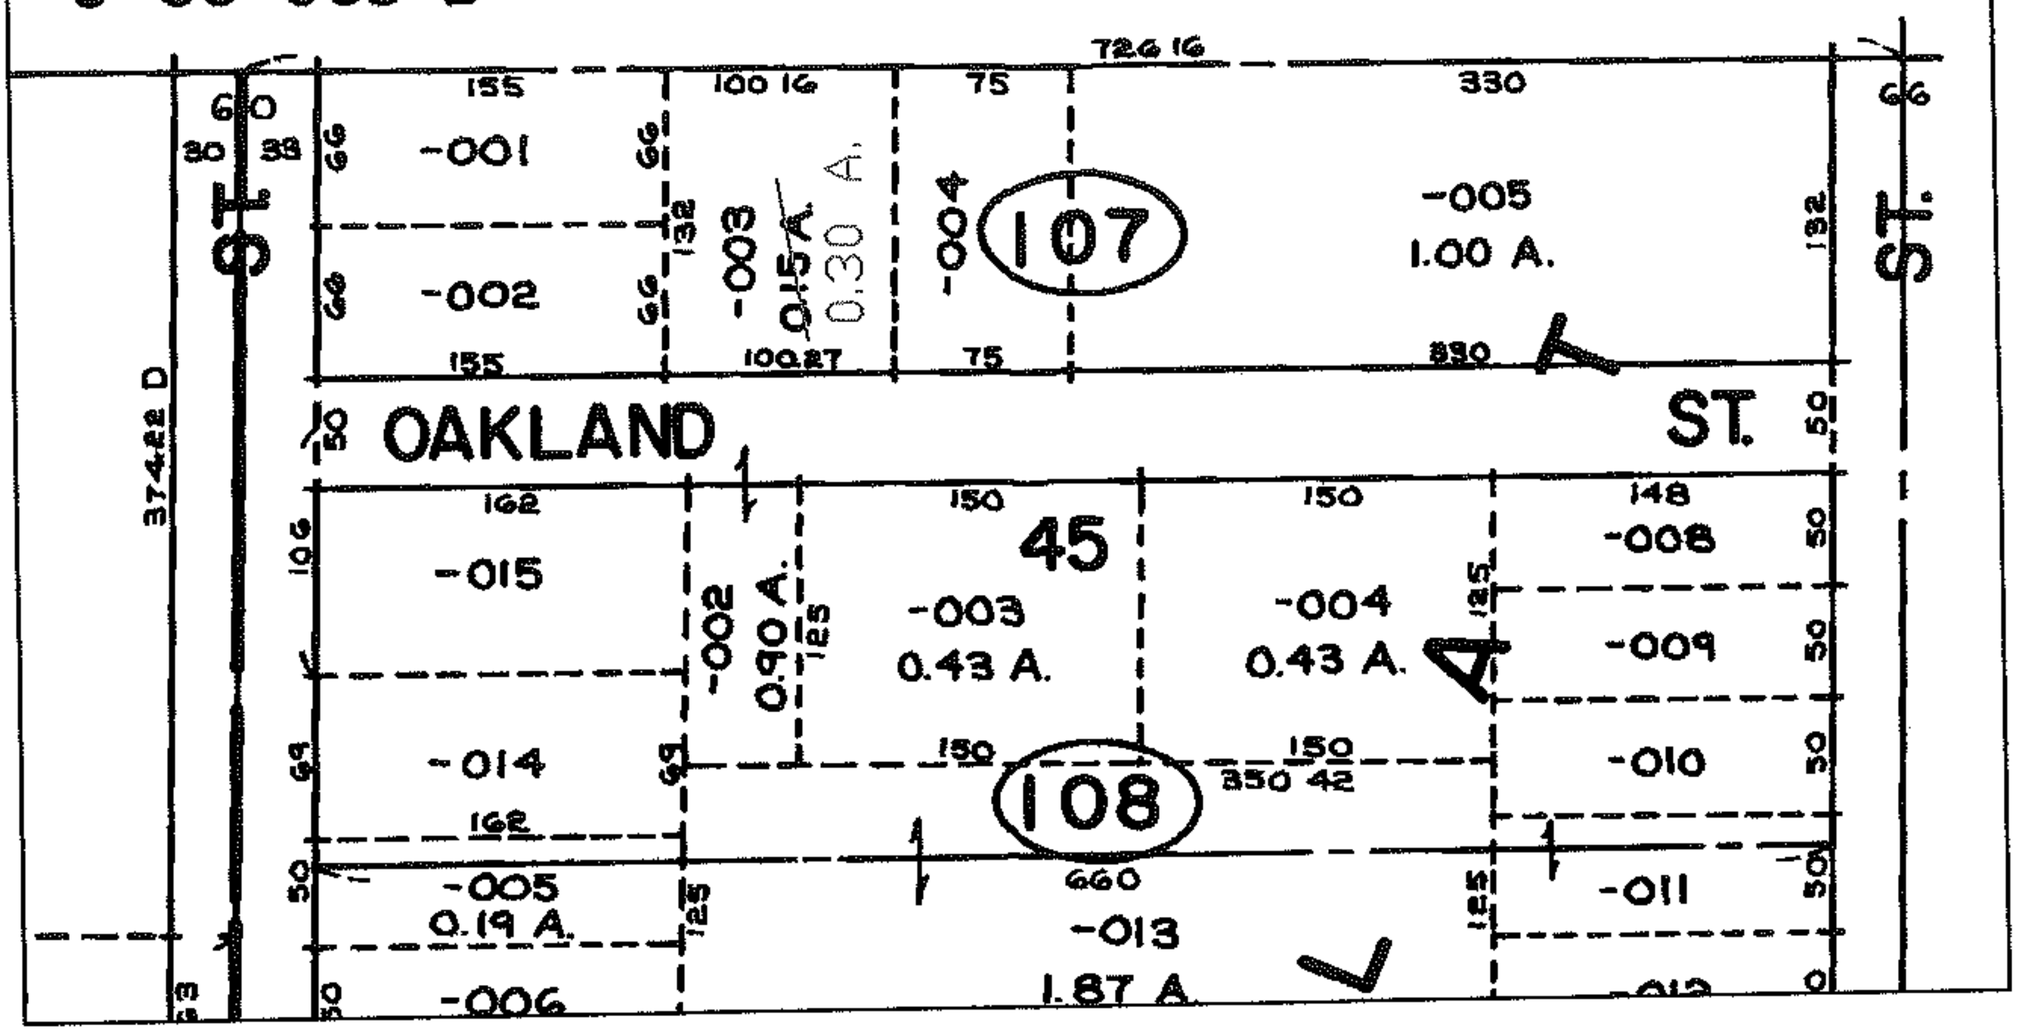

SPLITS/DEEDS PROCESSED
LORAIN COUNTY TAX MAP DEPARTMENT
226 MIDDLE AVE. ELYRIA, OHIO

SURVEYED BY: N/A
CLOSURE: N/A
MAP PAGE(S): 09-00-075-B
APPROVED BY: DRH DATE: 8/18/2005
SCALE: 1"= 200 PRIOR INSTRUMENT: OR 1315/115