RASTER

PARENT PARCEL: 15-00-023-000-011
CHILD PARCEL: --SAME--
STARTING POINT:

NO. 01192-D

AC. CORR. PER SURVEY
ERROR IN MAP DEPT.
REMOVE UPDATE LEGAL

N
W E
S

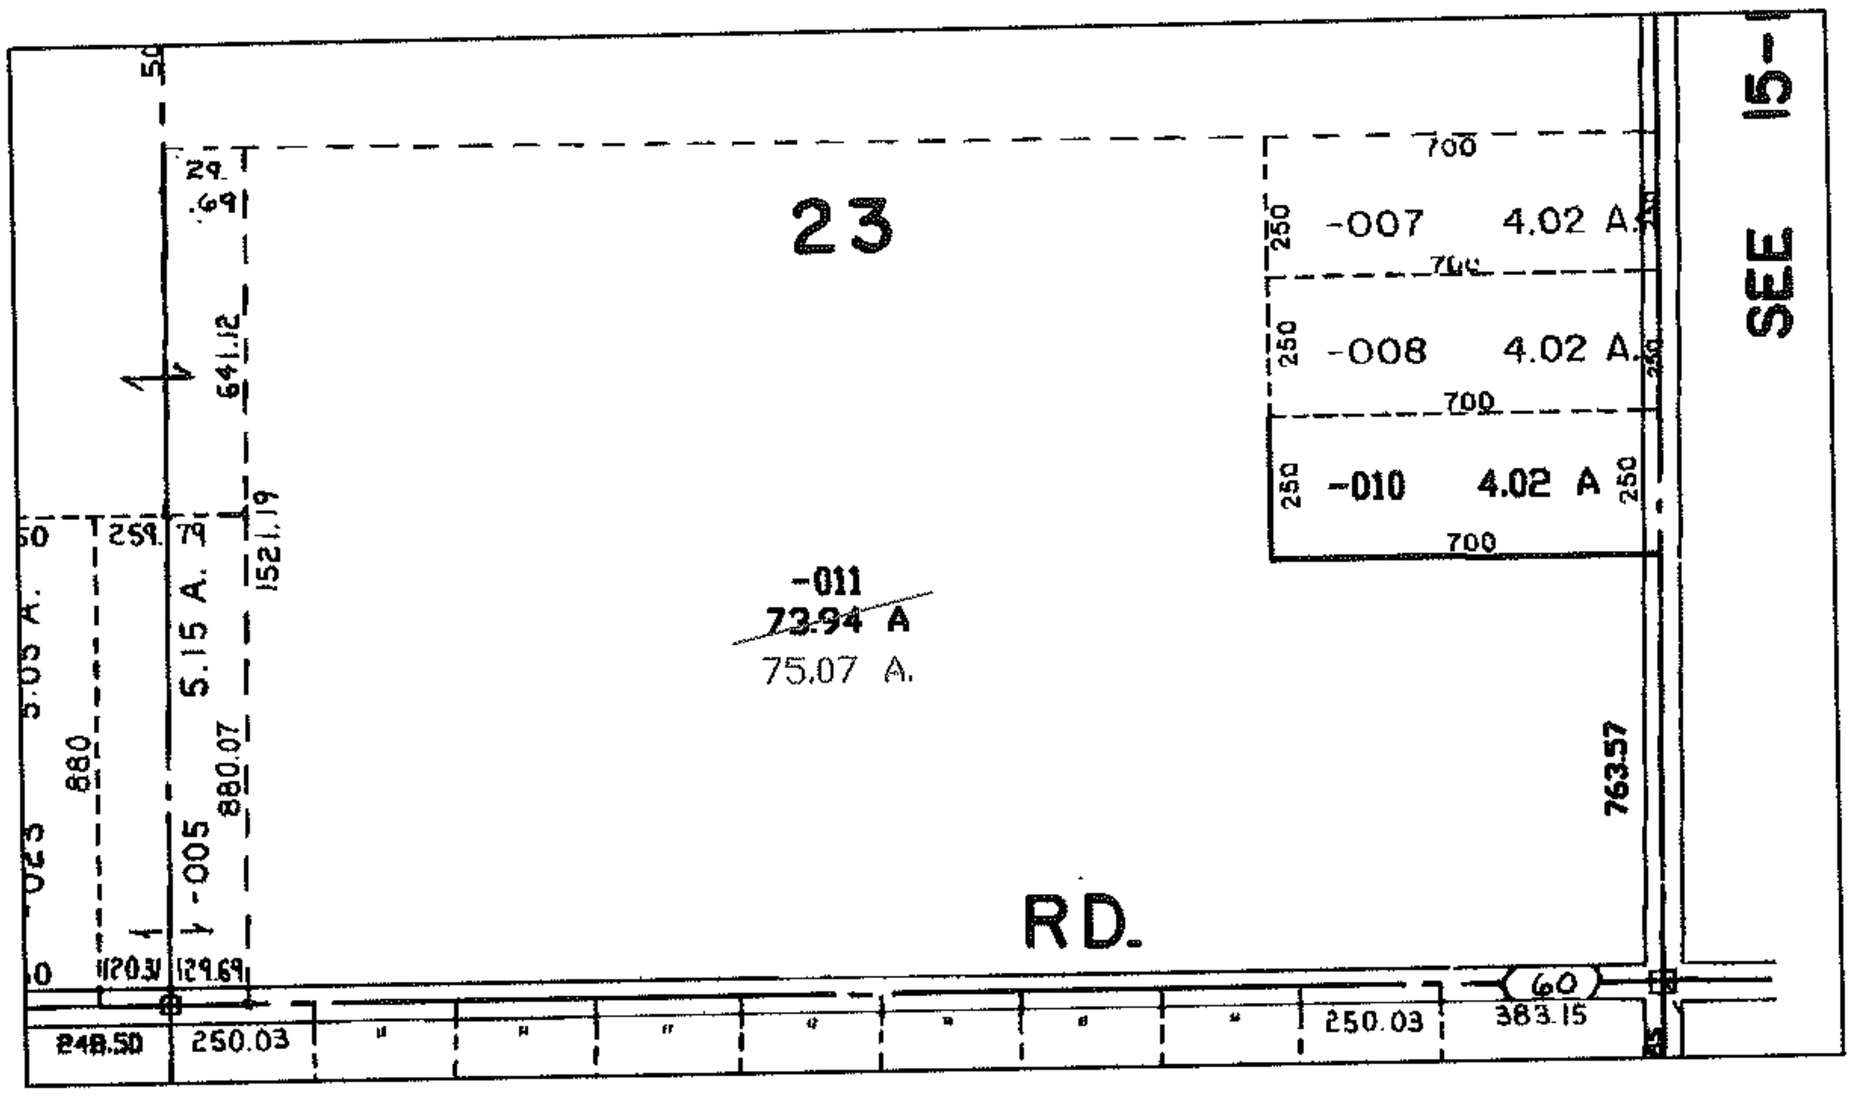

SPLITS/DEEDS PROCESSED

LORAIN COUNTY TAX MAP DEPARTMENT
226 MIDDLE AVE. ELYRIA, OHIO

SURVEYED BY: RODGER SIMON
CLOSURE: 1:10,000
MAP PAGE(S): 15-A
APPROVED BY: DRH DATE: 8/22/2005
SCALE: 1"= 200 PRIOR INSTRUMENT: 20050076101