RASTER

05-01200-D

PARENT PARCEL: 02-03-003-000-001
CHILD PARCEL: --SAME--
STARTING POINT:

AC. CORR.
PER SURVEY
C. HIRZEL

N
W E
S

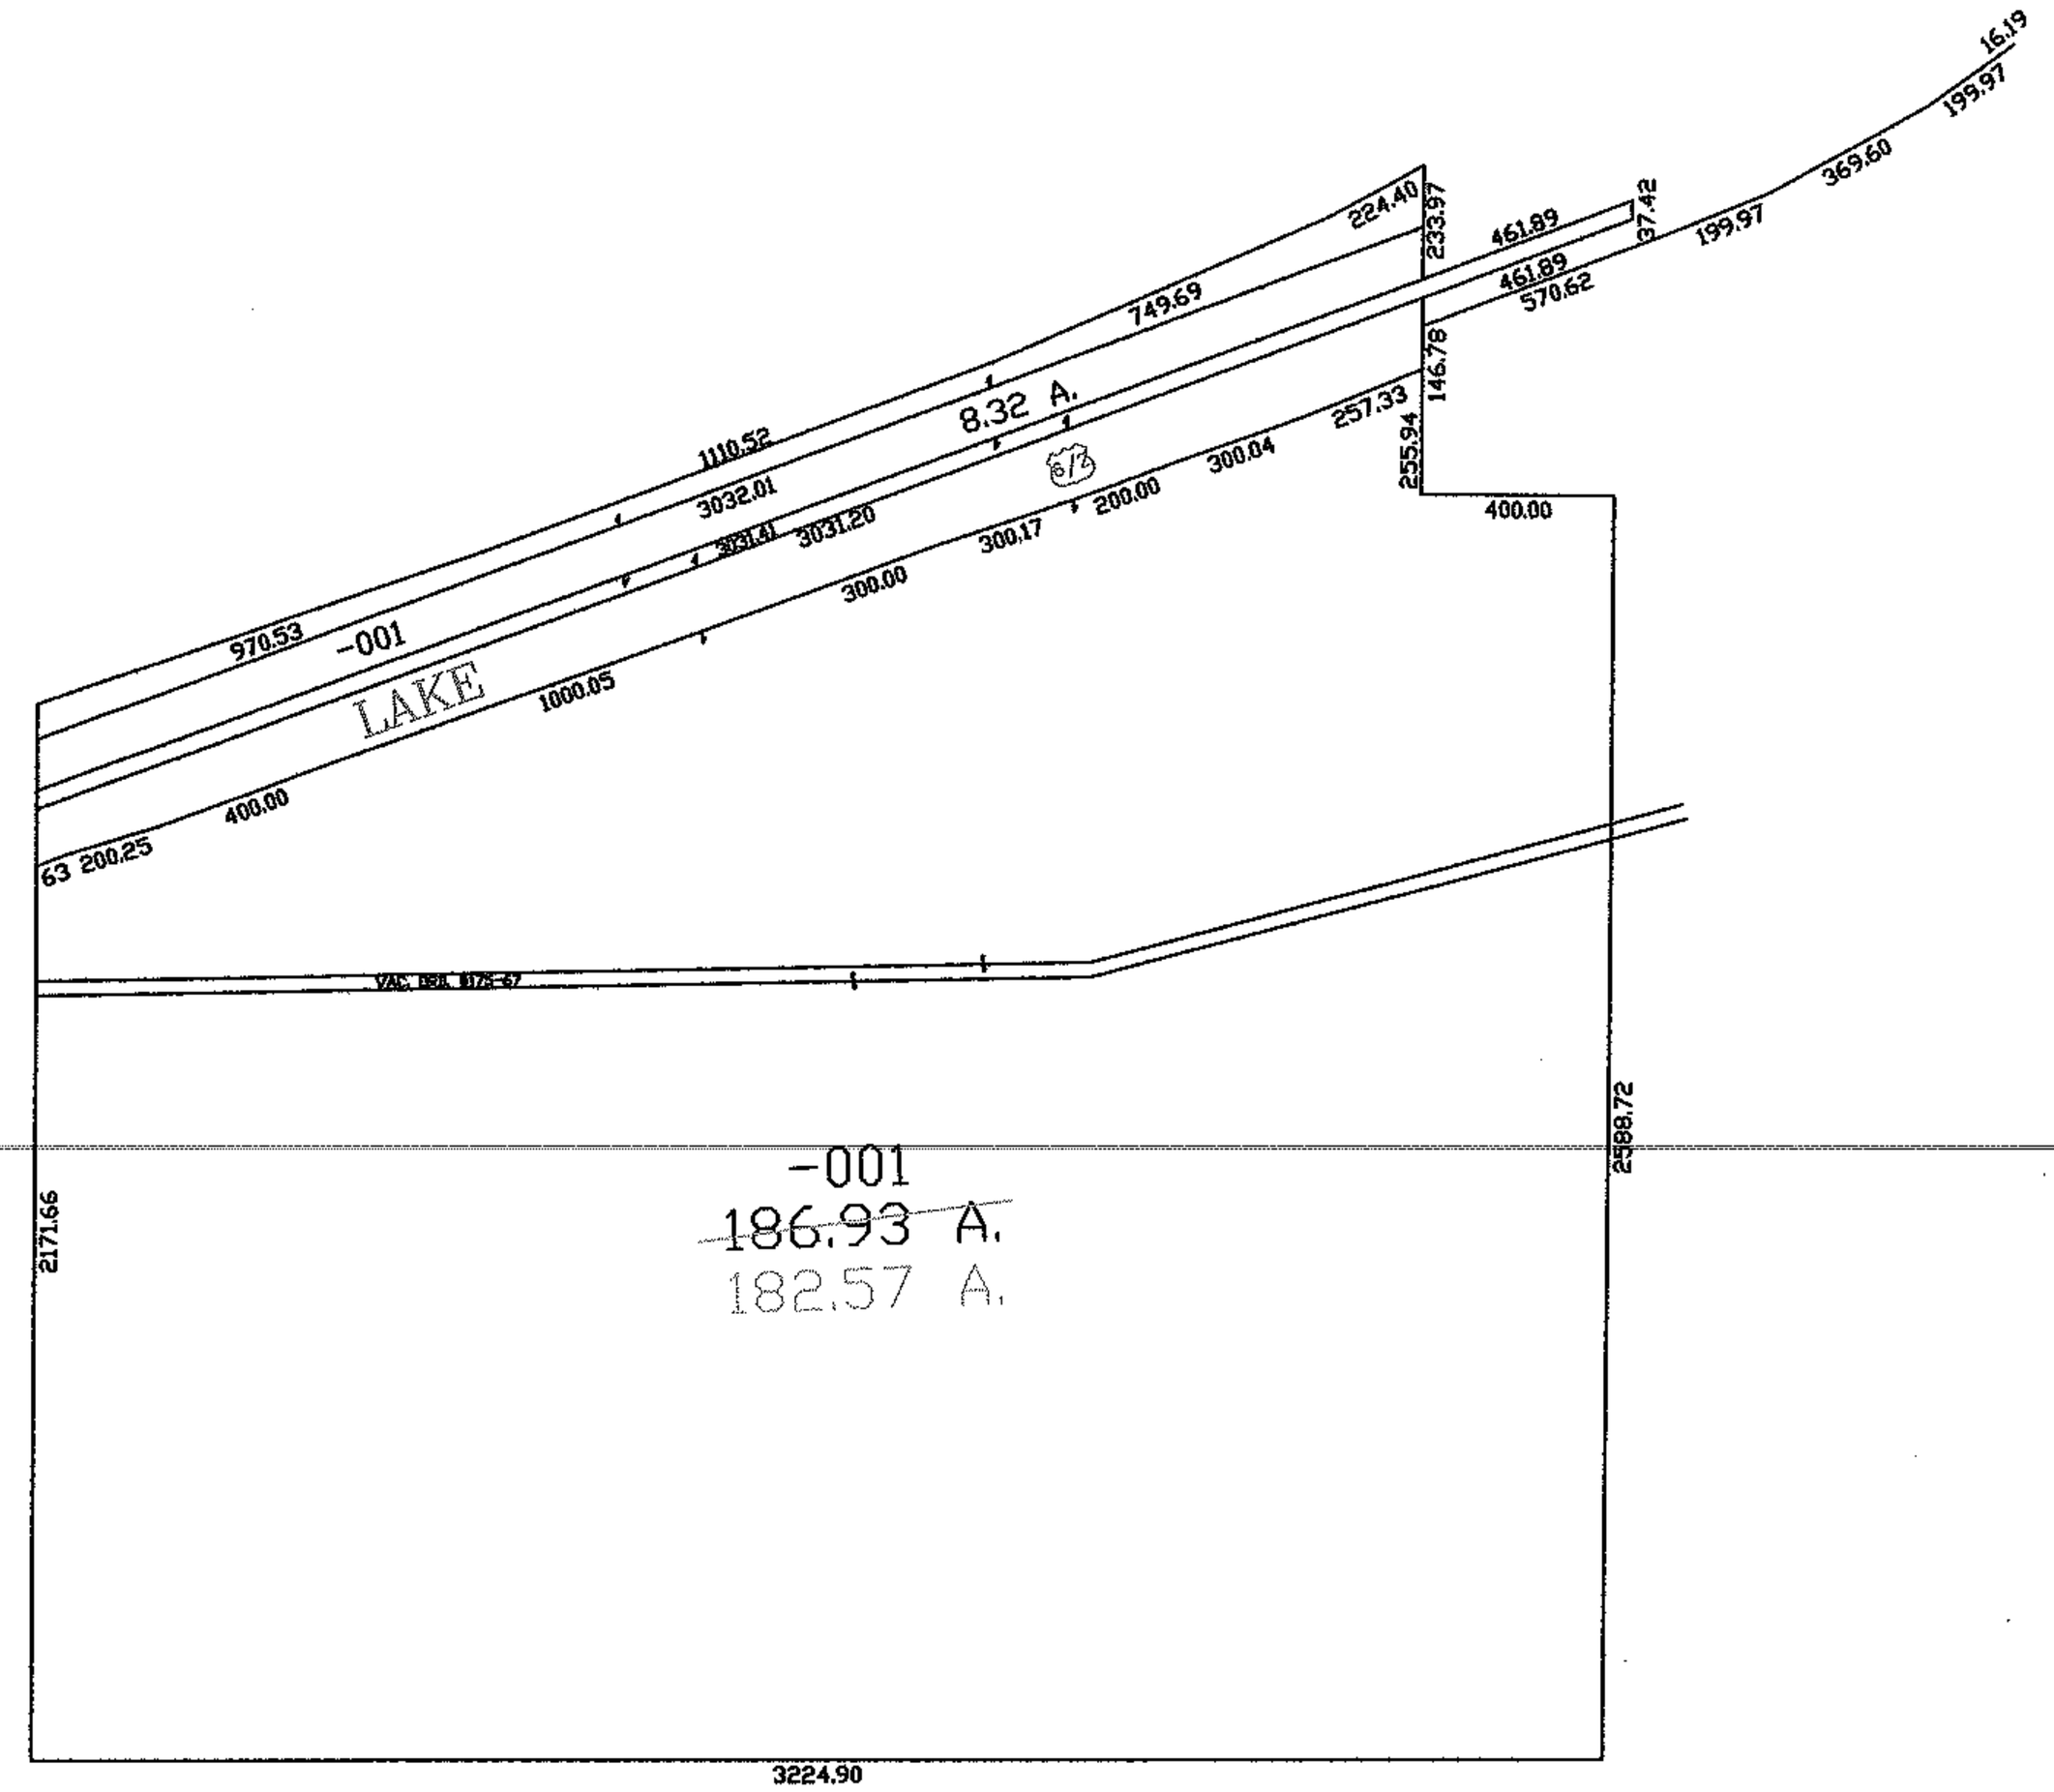

SPLITS/DEEDS PROCESSED

LORAIN COUNTY TAX MAP DEPARTMENT
226 MIDDLE AVE. ELYRIA, OHIO

SURVEYED BY: CHRISTOPHER M. HIRZEL
CLOSURE: 1:10,000
MAP PAGE(S): 2-E
APPROVED BY: DRH DATE: 9/23/2005
SCALE: 1"= 600' PRIOR INSTRUMENT: