RASTER

PARENT PARCEL:

CHILD PARCEL:

STARTING POINT: INT S LINE OF FRANCES ST AND NE CORNER OF SL 23

05-01223-V

VACATION ORD 4184-2005

N

W E

S

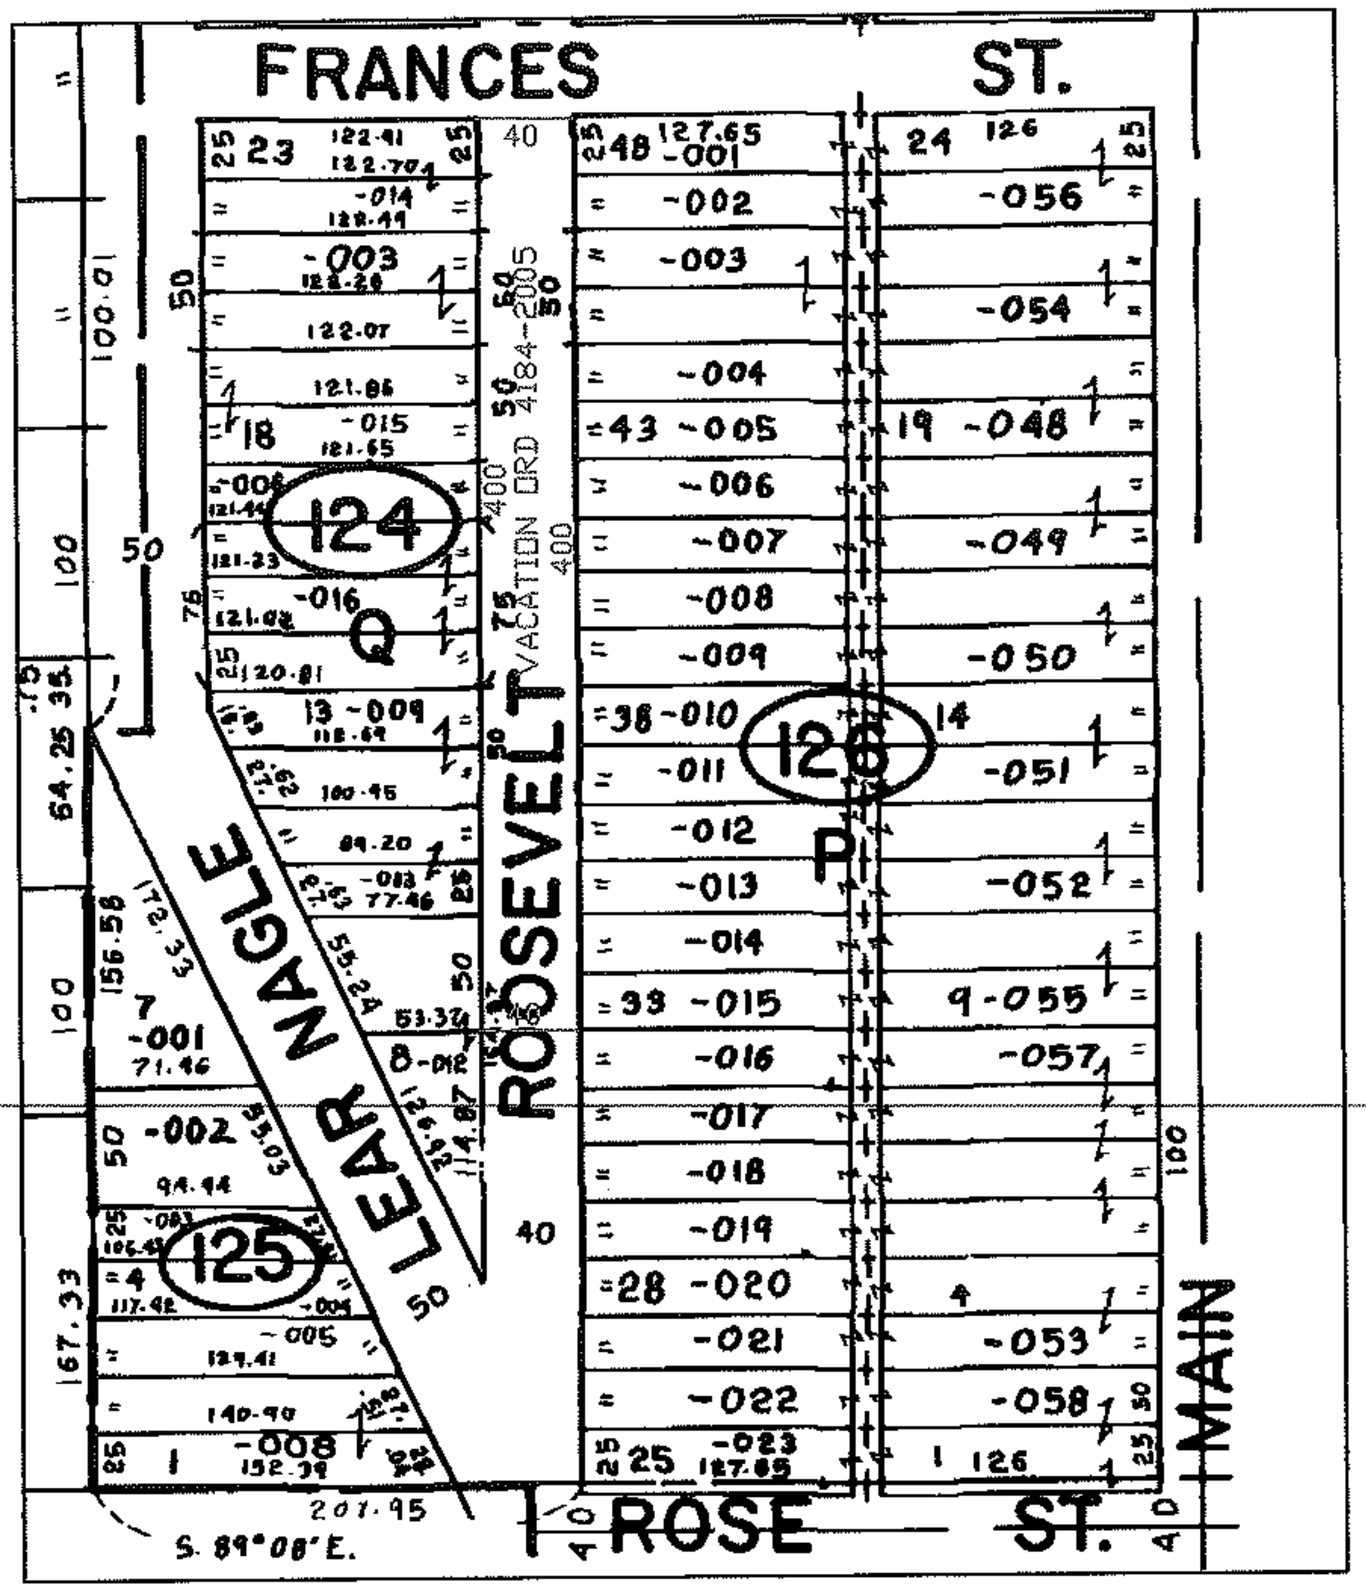

SPLITS/DEEDS PROCESSED

LORAIN COUNTY TAX MAP DEPARTMENT
226 MIDDLE AVE. ELYRIA, OHIO

SURVEYED BY: HOWARD R. SELEE

CLOSURE: 1:10,000

MAP PAGE(S): 07-00-007-C

APPROVED BY: DRH DATE: 6/15/2006

SCALE: 1"= 200 PRIOR INSTRUMENT: