PASTER

PARENT PARCEL: 05-01239-V

CHILD PARCEL:

STARTING POINT: NEVADA AVE

N

W E

S

ADD TO DUP
PER VACATION ORD
100-83 FROM SHEFFIELD

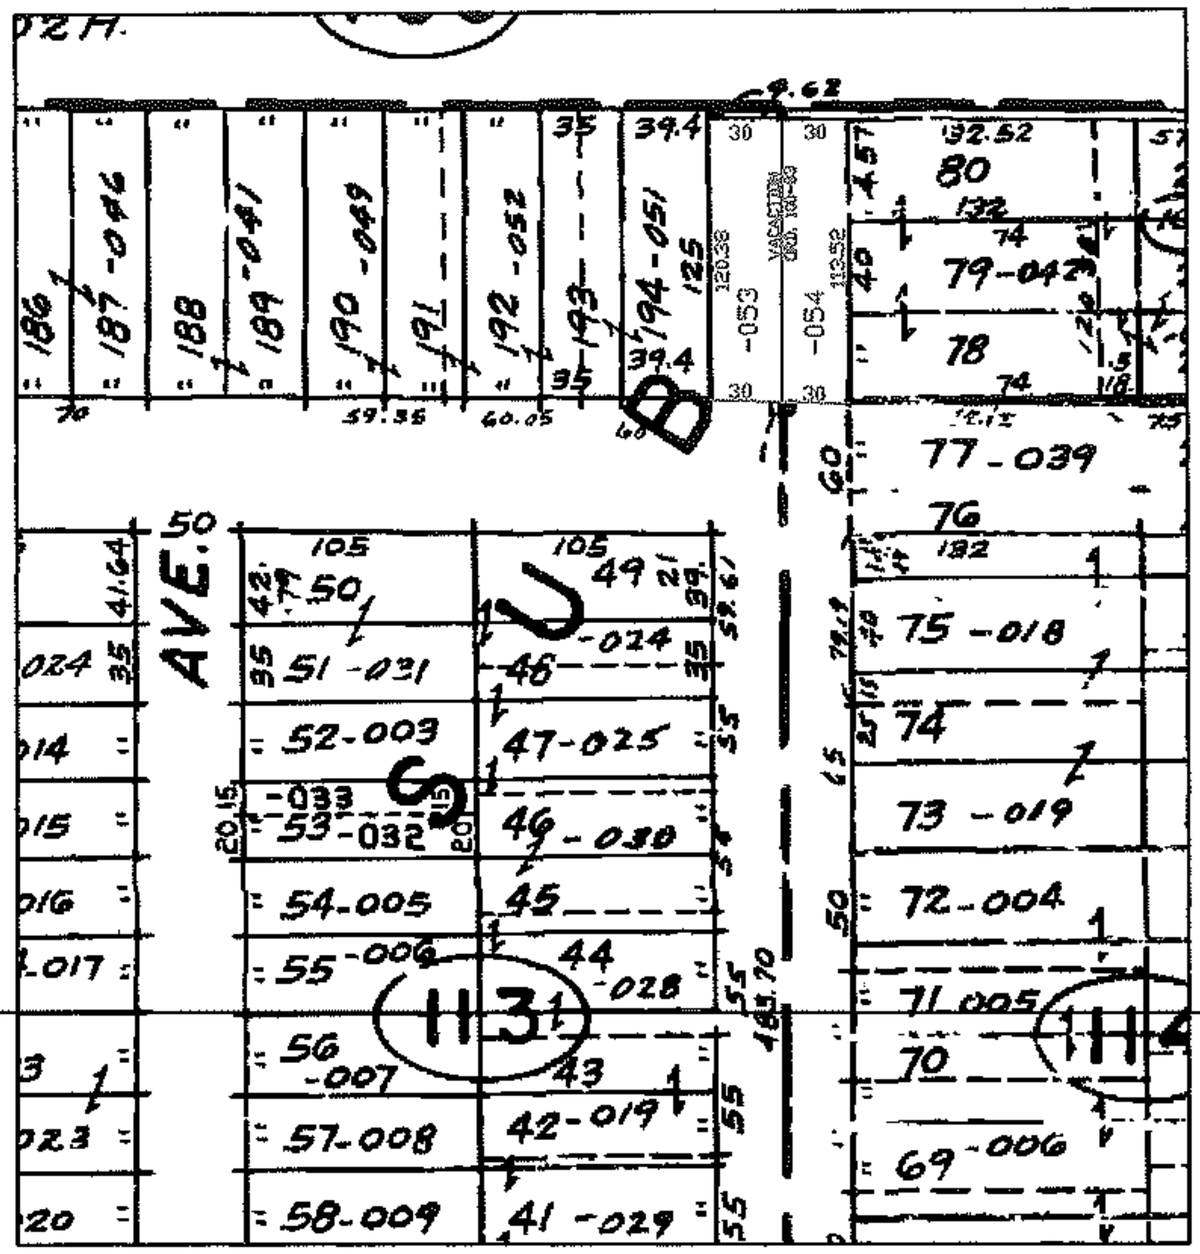

SPLITS/DEEDS PROCESSED

LORAIN COUNTY TAX MAP DEPARTMENT
226 MIDDLE AVE. ELYRIA, OHIO

SURVEYED BY: N/A

CLOSURE: N/A

MAP PAGE(S): 03-00-055-A

APPROVED BY: DRH DATE: 11/21/2005

SCALE: 1"= 200 PRIOR INSTRUMENT: ORD 100-83