RASTER

PARENT PARCEL: 05-01244-V

CHILD PARCEL:

STARTING POINT: INT CL EAST RIVER RD AND NORTH LINE OF O.L. 22

N

W E

S

VACATION ORDINANCE
05-937

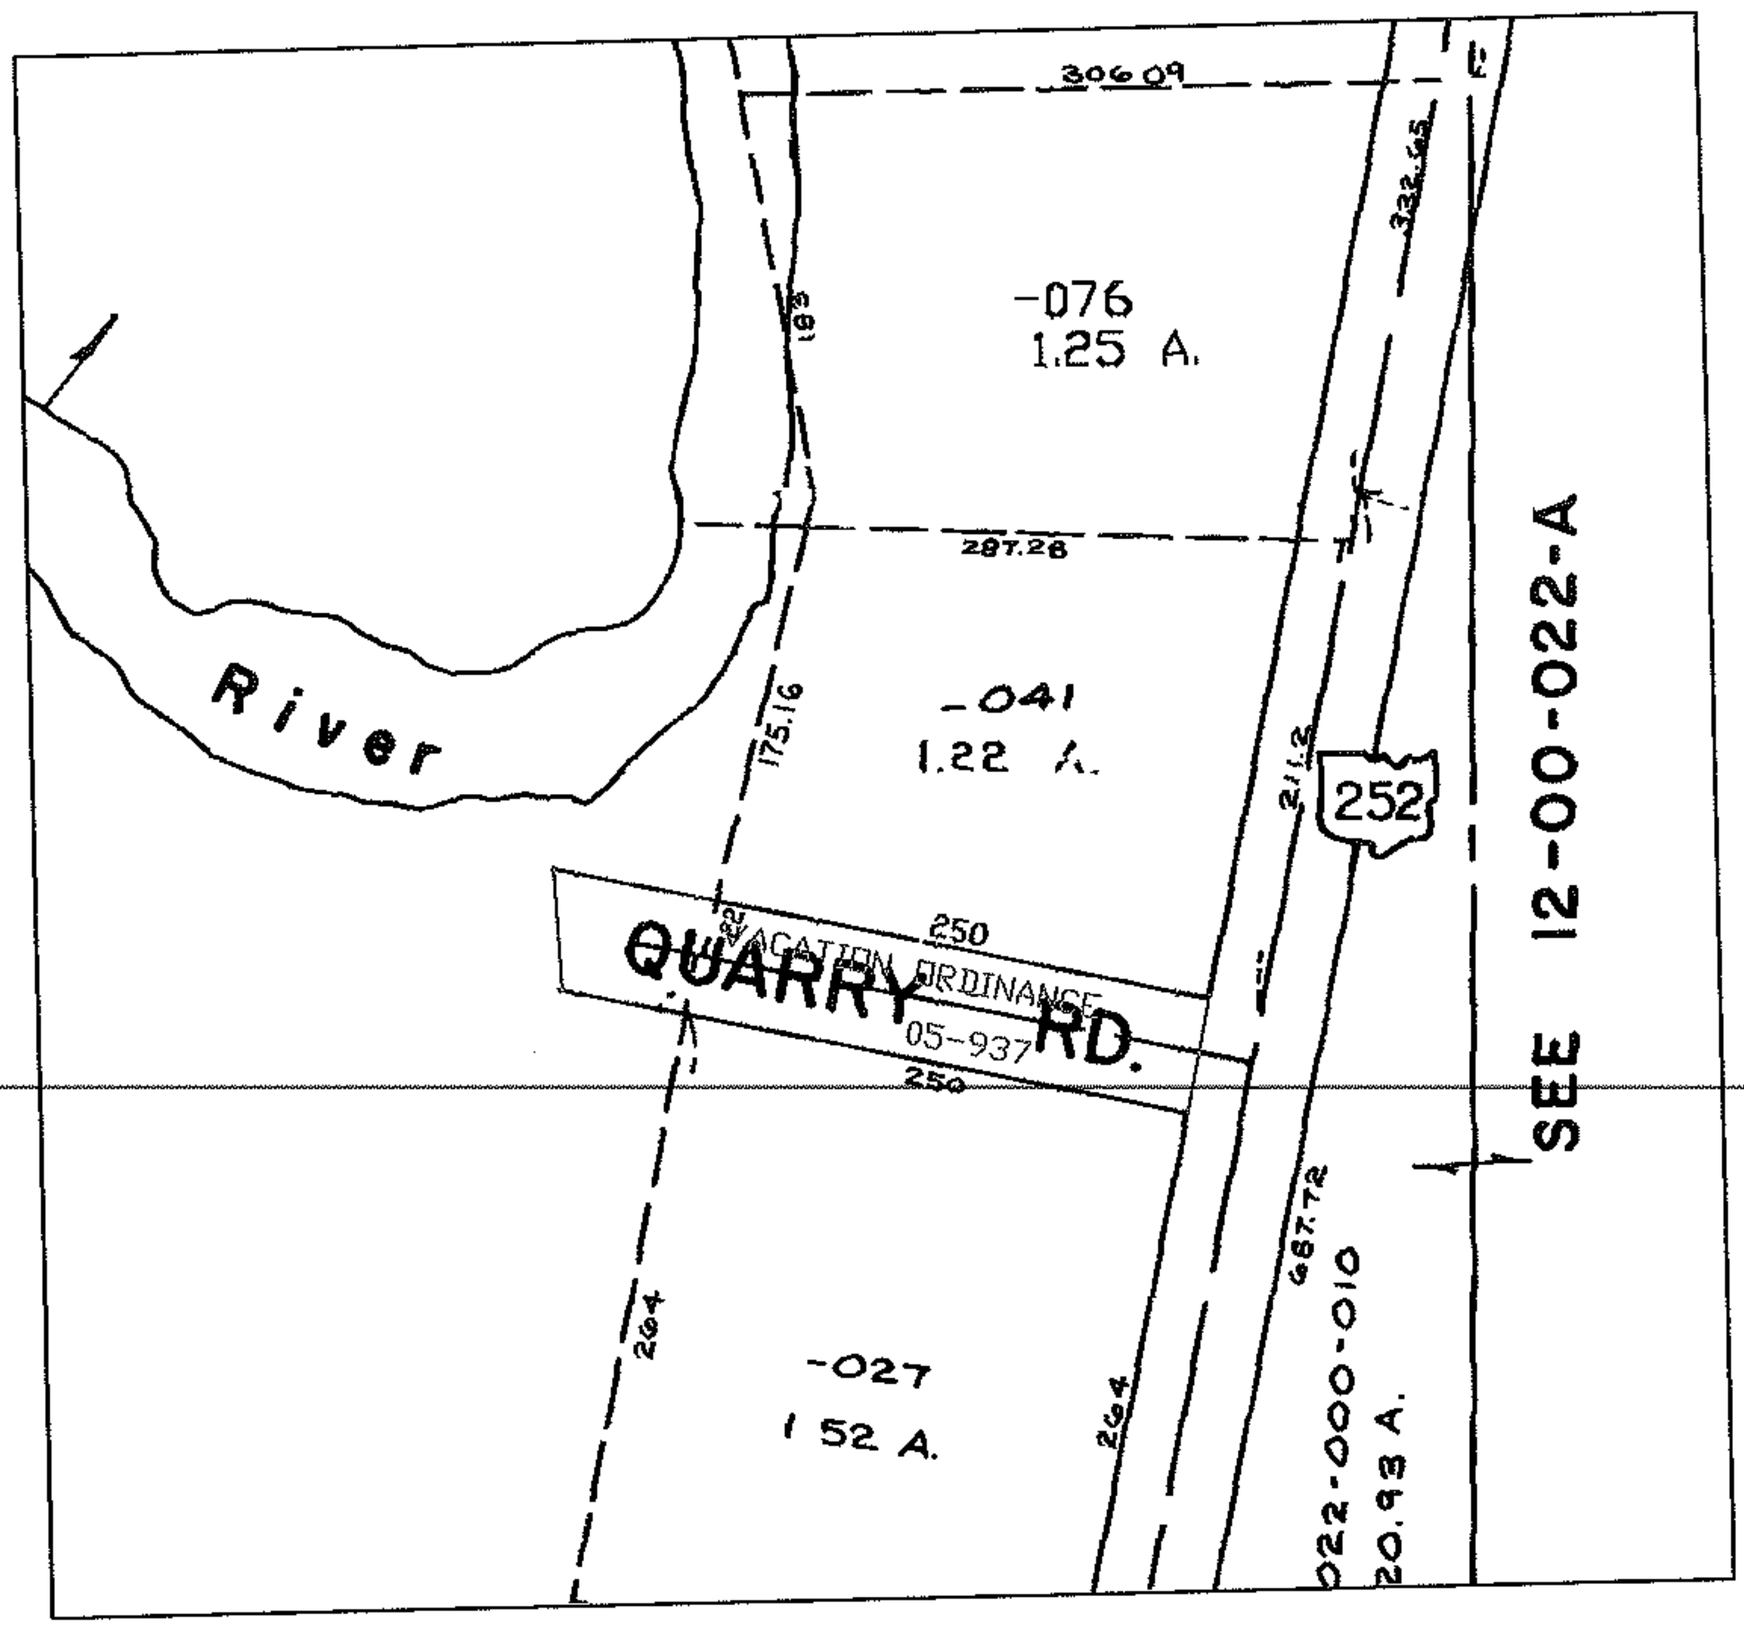

SPLITS/DEEDS PROCESSED

LORAIN COUNTY TAX MAP DEPARTMENT
226 MIDDLE AVE. ELYRIA, OHIO

SURVEYED BY: GUY P. HANLEY

CLOSURE: 1:10,000

MAP PAGE(S): 12-00-039-B

APPROVED BY: DRH DATE: 6/15/2006

SCALE: 1"= 200 PRIOR INSTRUMENT: