PASTER

PARENT PARCEL: 08-00-104-000-010

CHILD PARCEL: --SAME--

STARTING POINT:

05-01269-C

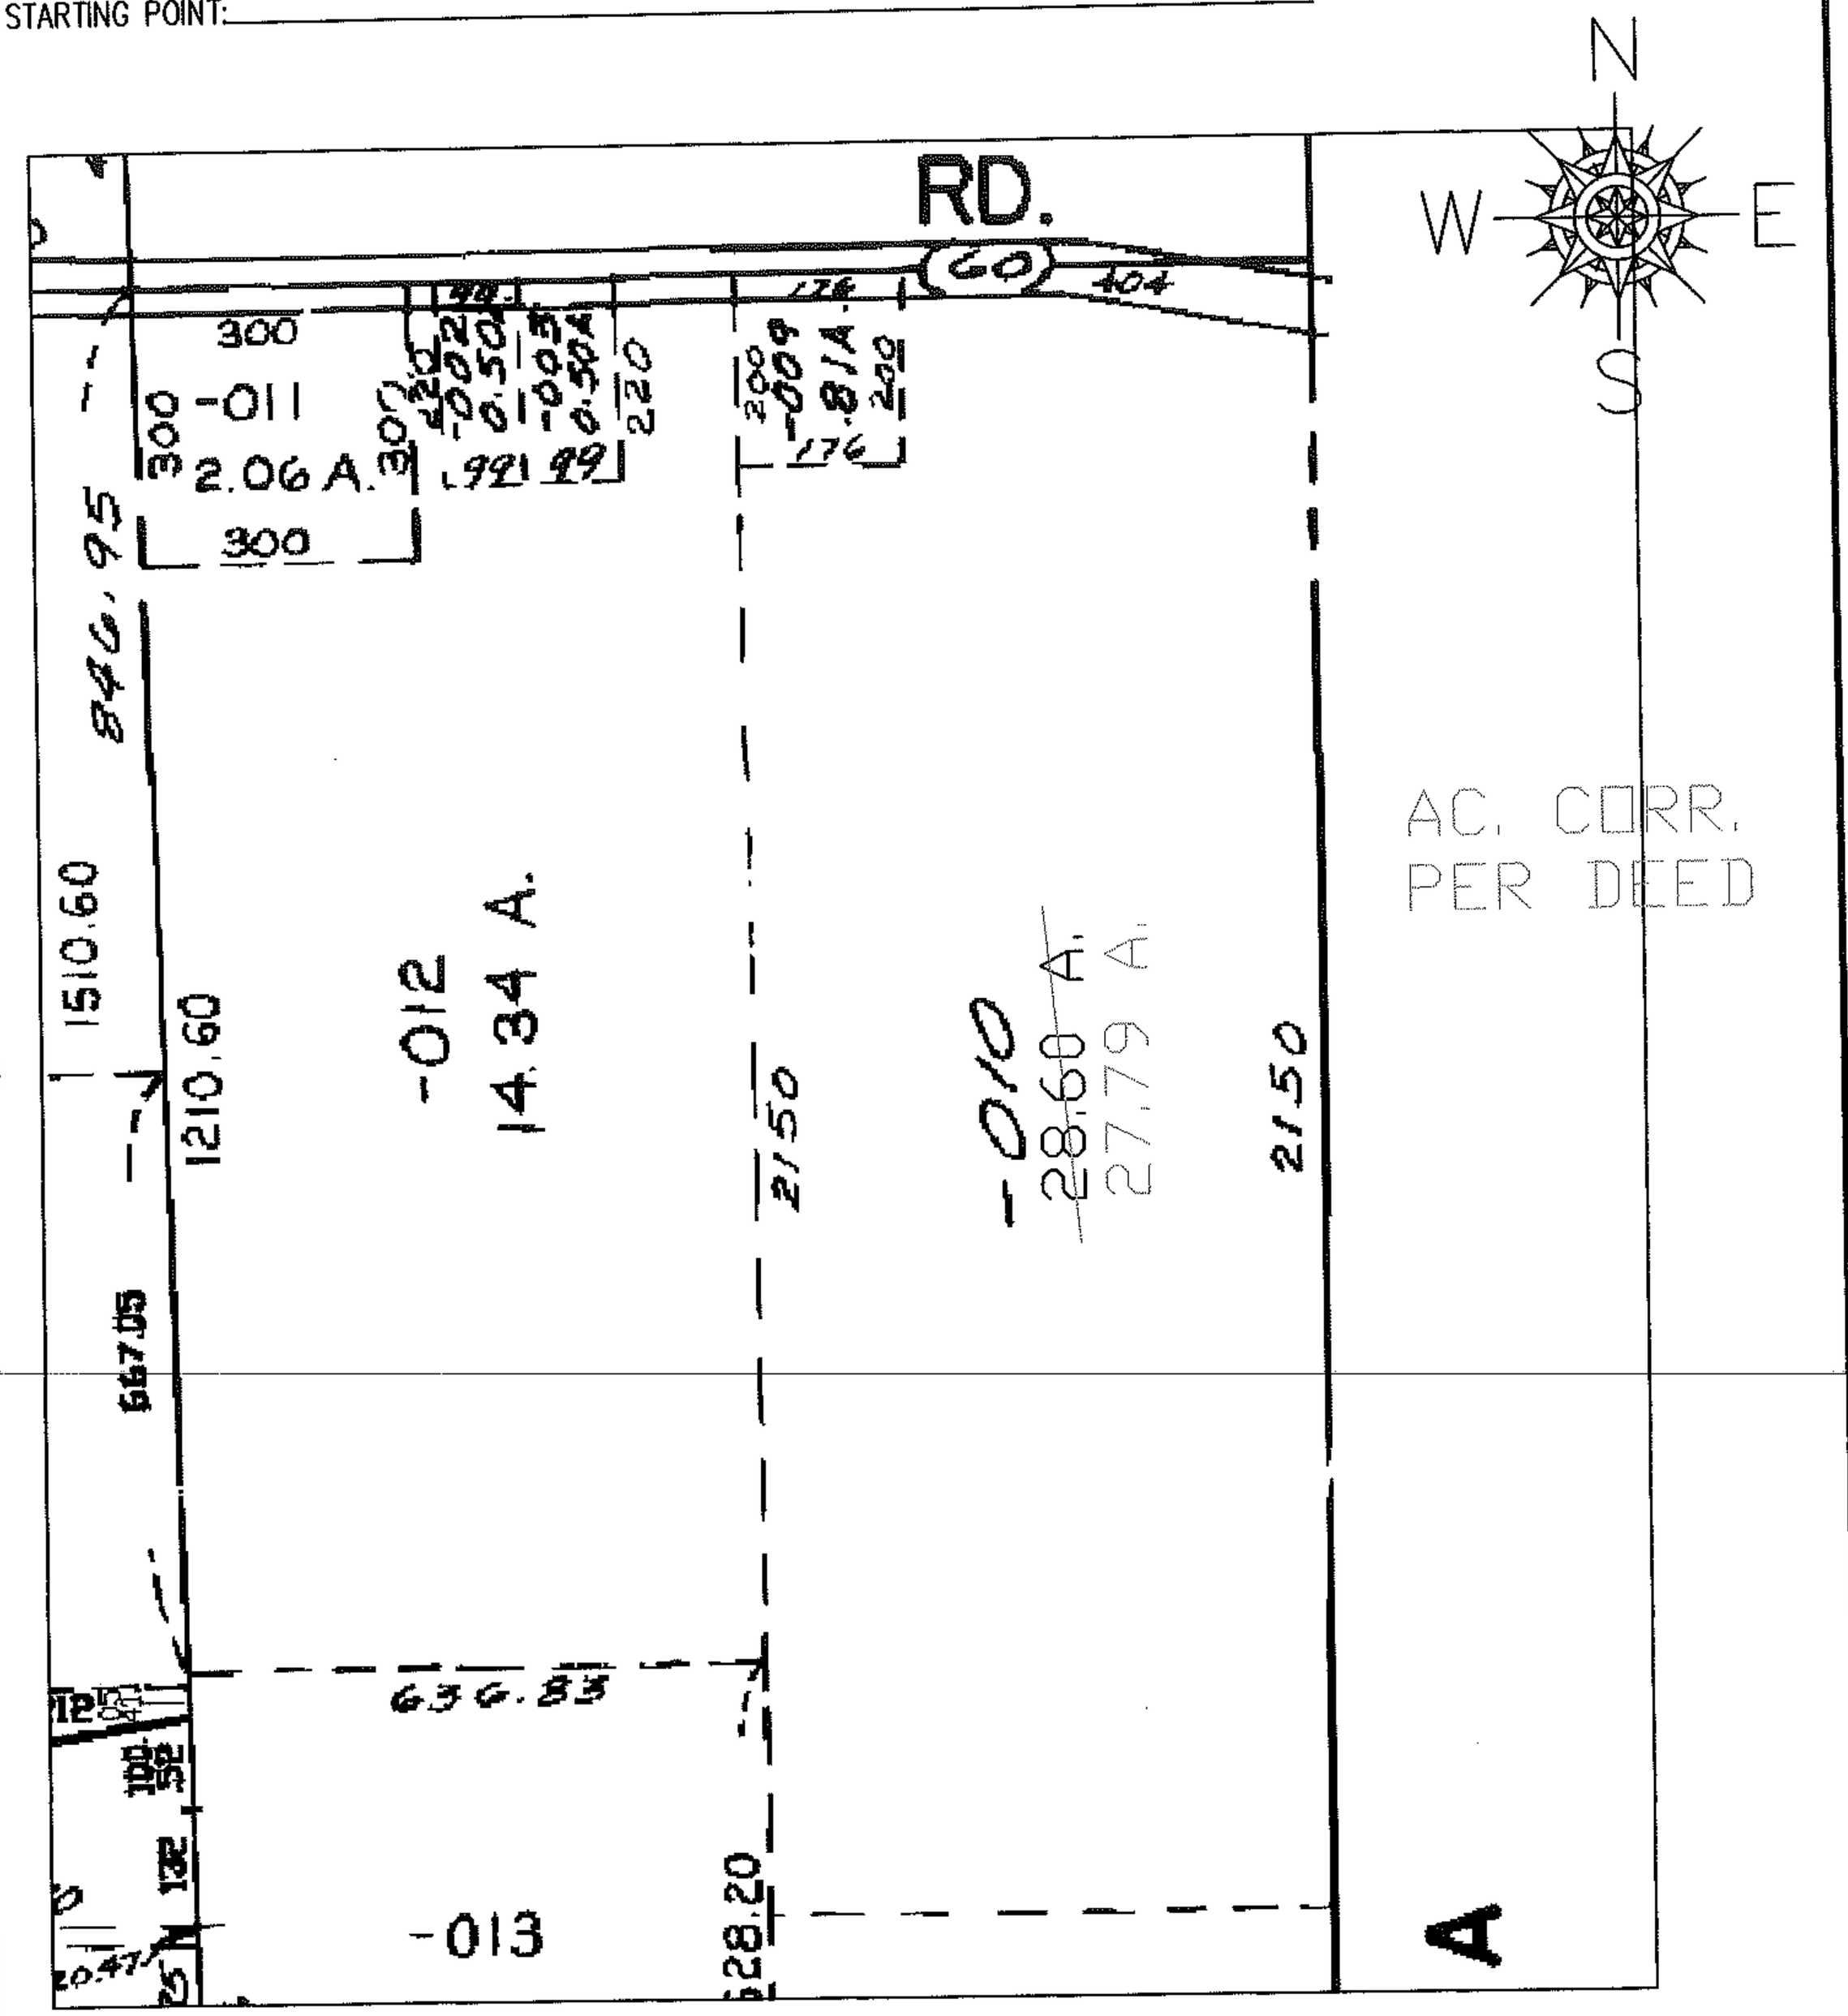

SPLITS/DEEDS PROCESSED

LORAIN COUNTY TAX MAP DEPARTMENT
226 MIDDLE AVE. ELYRIA, OHIO

SURVEYED BY: RAY E. HOLLIS

CLOSURE: 1:10,000

MAP PAGE(S): 08-D

APPROVED BY: DRH DATE: 1/30/2006

SCALE: 1"= 100 PRIOR INSTRUMENT: