RASTER

PARENT PARCEL: 06-24-002-000-061, 06-24-003-104-062, 06-24-005-000-001 & -002
CHILD PARCEL: 06-24-002-000-061, 06-00-003-104-062, 06-24-005-000-053
STARTING POINT: PIN AT SE CORNER OF O.L. 3

06-01283-C

AC. CORR. & COMB.
PER SURVEY
DALE HAYWOOD

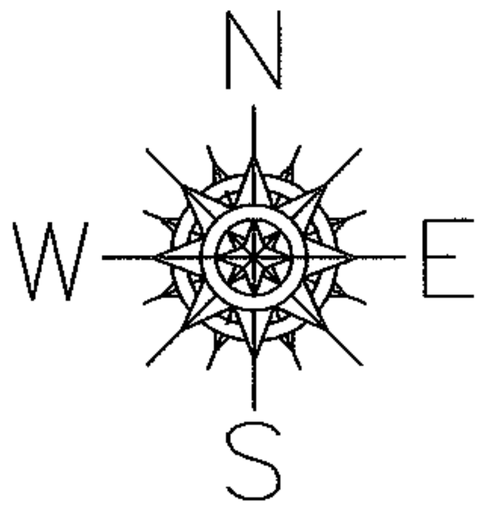

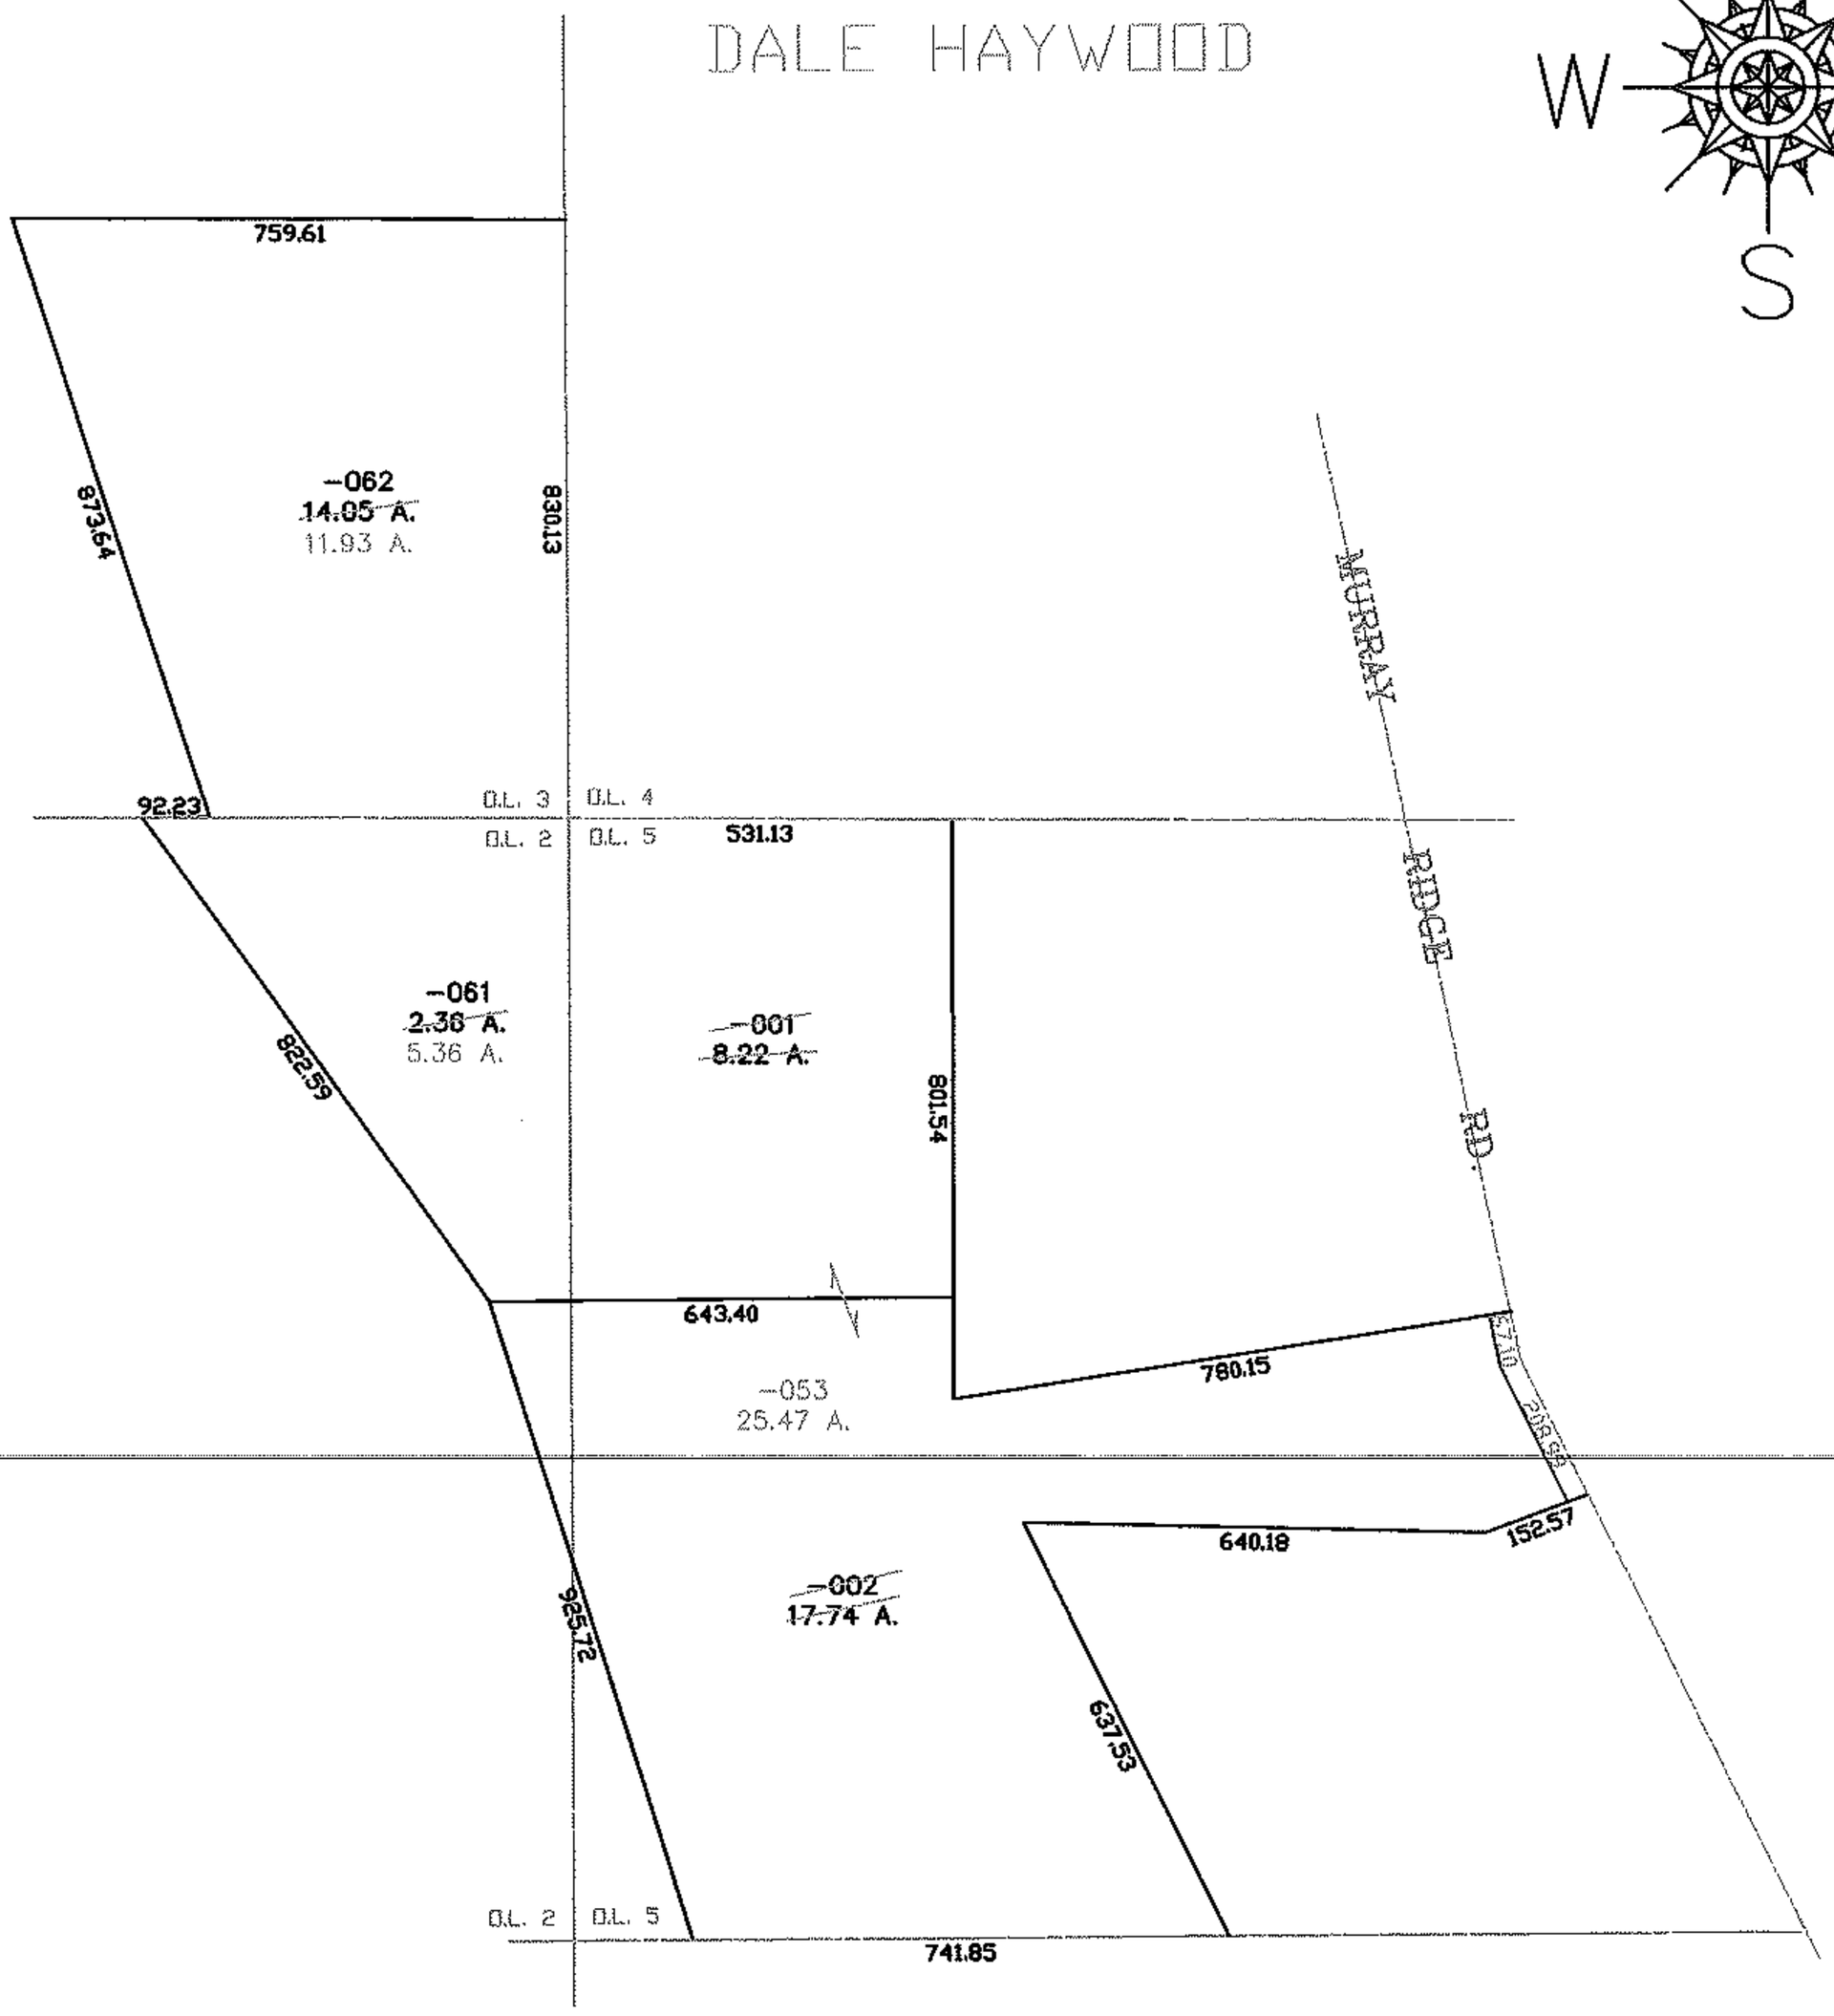

SPLITS/DEEDS PROCESSED
LORAIN COUNTY TAX MAP DEPARTMENT
226 MIDDLE AVE. ELYRIA, OHIO

SURVEYED BY: DALE HAYWOOD
CLOSURE: 1:10,000
MAP PAGE(S): 06-111
APPROVED BY: DRH DATE: 3/8/2006
SCALE: 1"= 400 PRIOR INSTRUMENT: 1168/554