RASTER

PARENT PARCEL: 11-00-032-000-009
CHILD PARCEL: 11-00-032-000-016, -017, -018
STARTING POINT:

06-01302-U

N
W E
S

UNCOMBINATION PER DEED

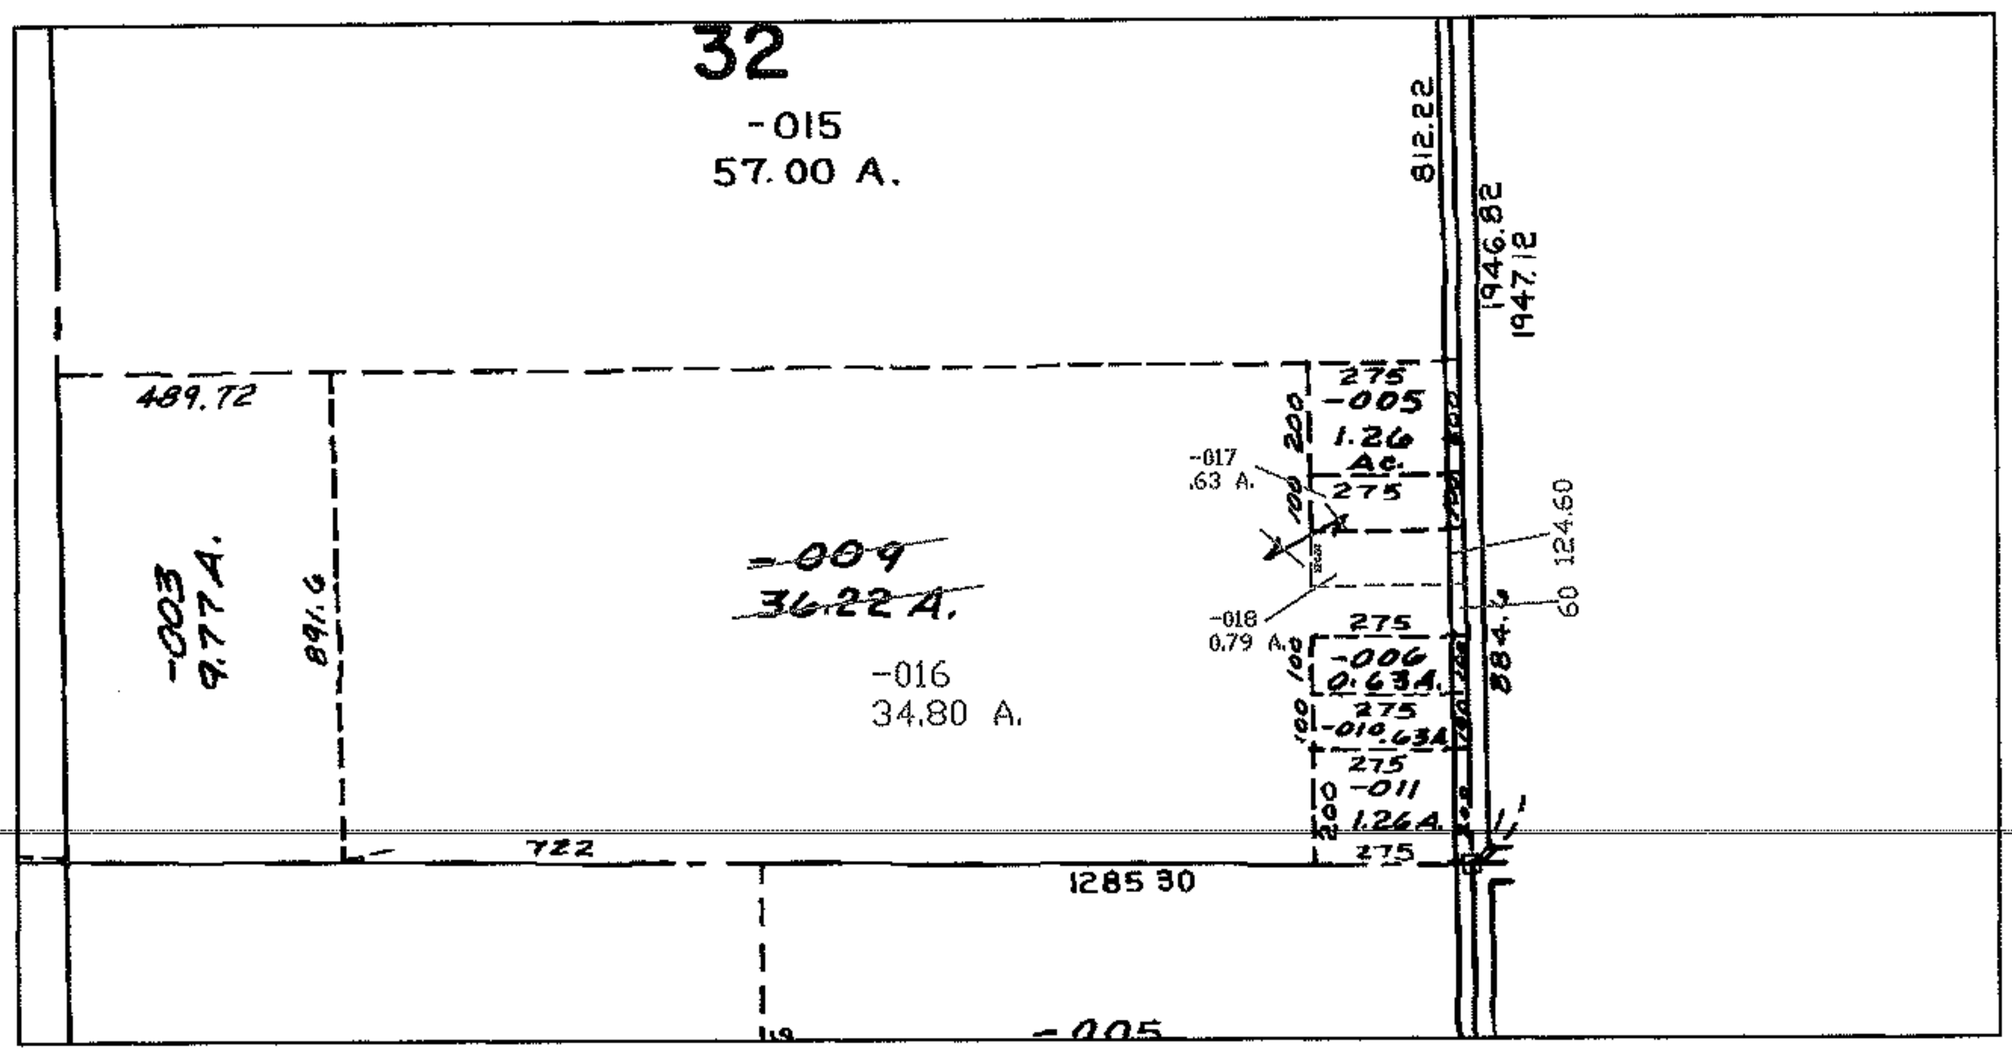

SPLITS/DEEDS PROCESSED

LORAIN COUNTY TAX MAP DEPARTMENT
226 MIDDLE AVE. ELYRIA, OHIO

SURVEYED BY: N/A
CLOSURE: N/A
MAP PAGE(S): 11-C
APPROVED BY: DRH DATE: 3/17/2006
SCALE: 1"= 200 PRIOR INSTRUMENT: 1334/373