RASTER

PARENT PARCEL: 06-026-022-102-018

CHILD PARCEL: --SAME--

STARTING POINT: INT EAST AVE AND 9TH ST

06-01304-C

FRONTAGE CORR
PER DEED

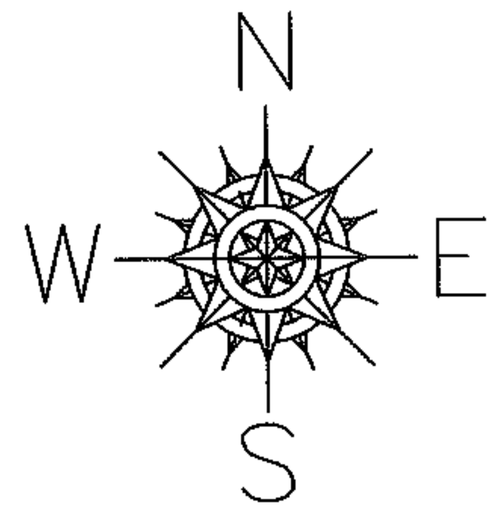

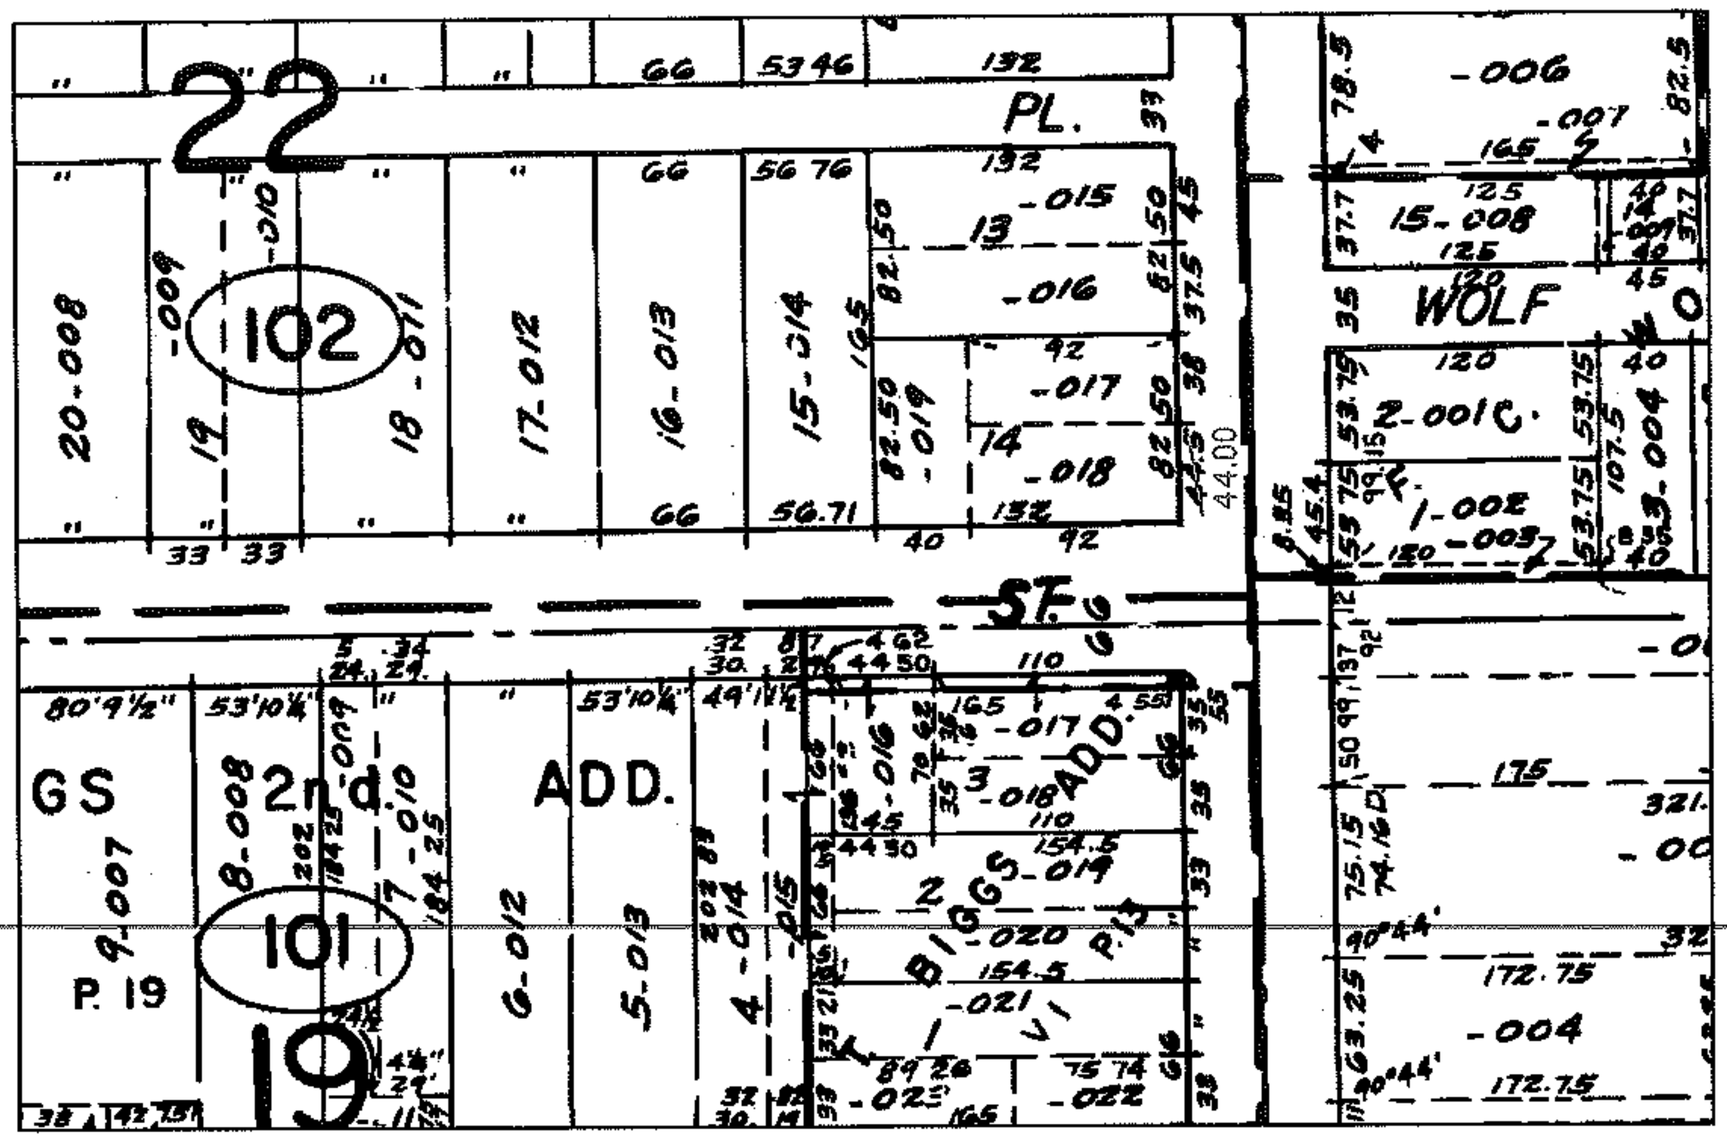

SPLITS/DEEDS PROCESSED

LORAIN COUNTY TAX MAP DEPARTMENT
226 MIDDLE AVE. ELYRIA, OHIO

SURVEYED BY: N/A

CLOSURE: N/A

MAP PAGE(S): 06-138

APPROVED BY: DRH DATE: 3/22/2006

SCALE: 1"= 200 PRIOR INSTRUMENT: 20050106865